

WATER SERVICE RECORD

Name VonCormier Real Estate Dev.

Service No. 115

Address 3 Todd Road

Location Lot #27 Sta. 3+17

~~XXXXXXXXXX~~ - New Service

W.O. # 8247

Comm 3-10-64


Date	Material	Amount	Total	Date	Material	Amount
6-23-62	Labor	2.13		10-17-63	Depos. T	50.00
	10% O.H.	.21	2.34	3-10-64	Paid by SHC# 139	8.55
	13' 3/4" Copper tubing @.42		5.46			58.55
	1 hr. Trucking @3.00		3.00			
	BILL WHEN CONNECTED		10.80		NON CHARGE	
10/23/63	Labor	4.73		6-23-62	Labor	2.13
	10% O.H.	.47	5.20		22' 3/4" Copper tubing @.42	9.24
	68' 3/4" Copper Tubing @ .42		28.56		1 3/4" C Corp Cock	4.91
	1 3/4" Cx 1/2 I.W.H. Stop & Waste		6.17		1 3/4" C. Curb Cock	6.28
	2 3/4" C3 Part Unions @ 2.41		4.82		1 Box & Rod	4.90
	1 Hr. Trucking @ 3.00		3.00			27.46
			58.55		1 1/2 Straight Tailpiece	50
					1 1/2 Offset Tailpiece	50
						28.46

DATE _____

TOWN OF LEXINGTON — BOARD OF PUBLIC WORKS

WATER DIVISION

Sketch of Service Here

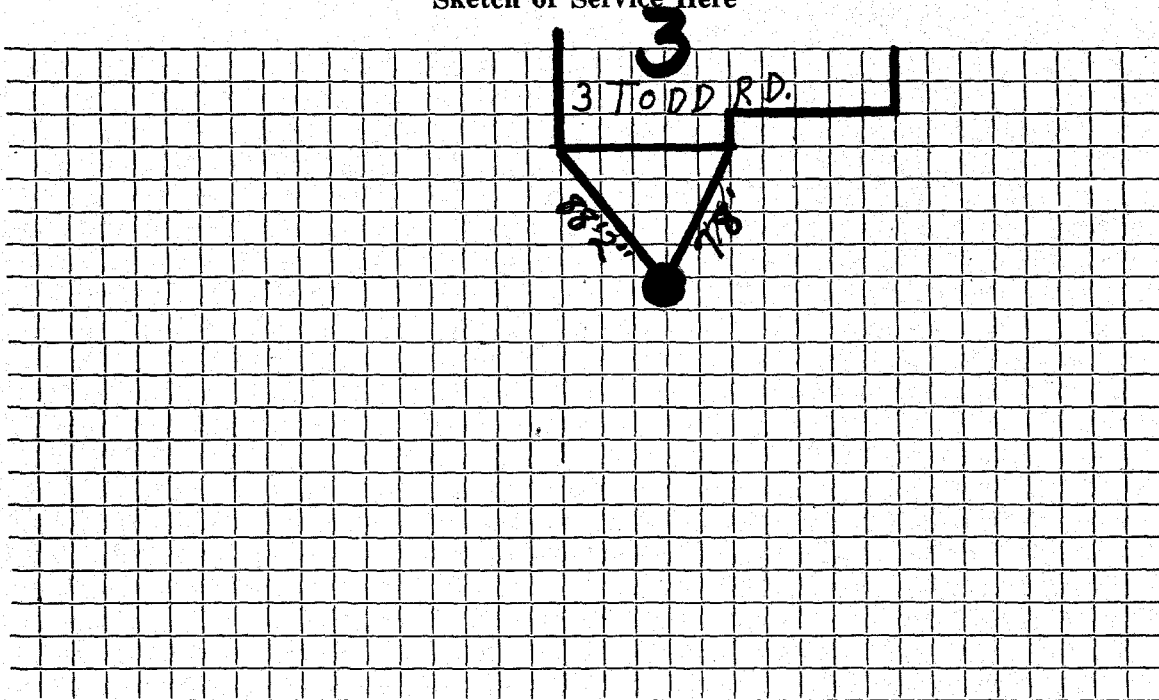

Connection made in Street. Work completed

Remarks:

.....

.....