

WATER SERVICE RECORD

Name Charles Chiklis

Service No. 101

Address ~~2 Bowser Road~~ 4 Todd Road

1901

Location Lot #34 (8/22/77 per Eng.)
Sta. 9+15 El. 180.38

Repair—Renewal—New Service

WO# 7499


Comm 10-29-62

Date	Material	Amount	Total	Date	Amount	
6-22-62	Labor	2.13		8-6-62	Deposit	50.00
	10% O.H.	.21	2.34	2-4-63	Pr. ck.	4.52
20'	3/4" Copper tubing @.42		8.40			54.52
1	hr. Trucking @3.00		3.00			
	BILL WHEN CONNECTED		13.74		NON CHARGE	
9-18-62	Labor	4.02		6-22-62	Labor	2.13
	10% O.H.	.40	4.42	21'	3/4" Copper tubing @.42	8.82
59'	3/4" Copper tubing @.42		24.78	1	3/4" C Corp Cock	4.91
1	3/4" CX $\frac{1}{2}$ I.W.H. Stop & Waste		6.17	1	3/4" C Curb Cock	6.28
1	3/4" C3 Part Union		2.41	1	Box & Rod	4.90
1	Hr. Trucking @3.00		3.00			27.04
			54.52	9-18-62		
				1	$\frac{1}{8}$ Straight Tailpiece	.50
				1	$\frac{1}{8}$ Offset Tailpiece	.50
						28.04

TOWN OF LEXINGTON — BOARD OF PUBLIC WORKS

WATER DIVISION

Sketch of Service Here

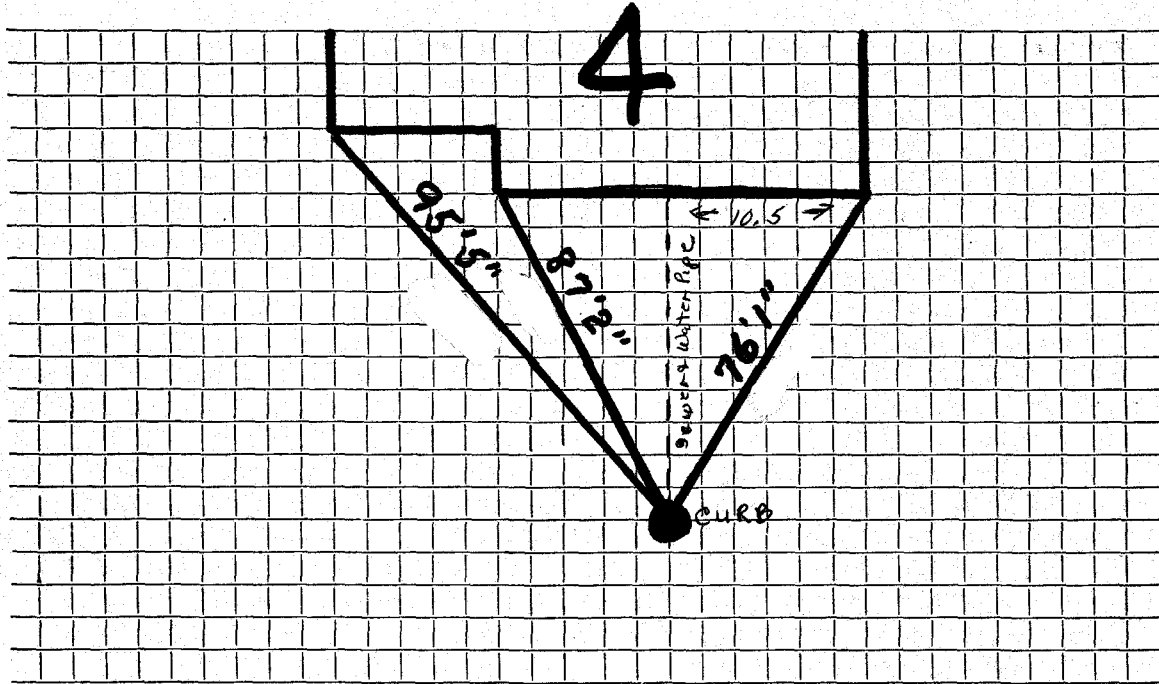

Connection made in Street. Work completed

Remarks:

.....

.....