

WATER SERVICE RECORD

Name

Service No.

Address

Location **5 TODD RD**

Repair—Renewal—New Service **UPGRADE McLAUGHLIN**


Date	Material	Amount	Total	Date	Material	Amount	Total
JAN	99			4/23/62			
	84'				24'		
	1" COPPER				3/4 COPPER		
	1 3/4" UNION				1 3/4 CORP		
					1 3/4 CORB STOP		
					BRK ROD		

DATE _____

TOWN OF LEXINGTON — BOARD OF PUBLIC WORKS

WATER DIVISION

Sketch of Service Here

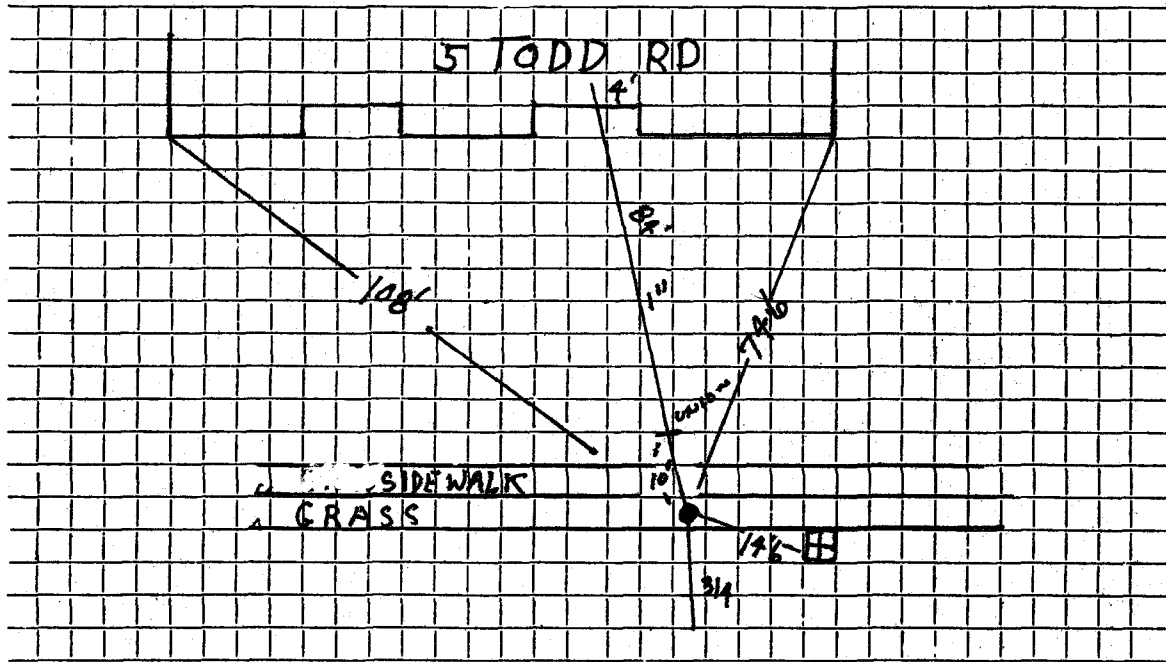

Connection made in Street. Work completed

Remarks:
.....
.....