

WATER SERVICE RECORD

Name Robert L. Johnson

Service No. 149

Address 6 Todd Road

Location Lot #23 Sta. 9+75 El. 180.87 on 1 Bowser Road

~~Electric Service~~ - New Service W.O. #7688

Comm 12-10-62


Date	Material	Amount	Total	Date	Amount	
6-22-62	Labor	2.13		10-25-62	Deposit	50.00
	10% O.H.	.21	2.34	12-10-62	Paid by SHE #172	7.79
	9' 3/4" Copper tubing @.42		3.78			57.79
	1 hr. Trucking @3.00		3.00			
	BILL WHEN CONNECTED		9.12		NON CHARGE	
10-30-62	Labor	3.71		6-22-62	Labor	2.13
	10% O.H.	.37	4.08		9' 3/4" Copper tubing @.42	3.78
	80' 3/4" Copper tubing @.42		33.60		1 3/4" C Corp Cock	4.91
	1 3/4" CX 1/2 I.W.H. Stop & Waste		6.17		1 3/4" C Curb Cock	6.28
	2 3/4" C3 Part Unions @2.41		4.82		1 Box & Rod	4.90
			57.79			22.00
				10/30/62		
					1 1/2 Straight Tailpiece	.50
					1 1/2 Offset Tailpiece	.50
						23.00

DATE _____

TOWN OF LEXINGTON — BOARD OF PUBLIC WORKS

WATER DIVISION

Sketch of Service Here

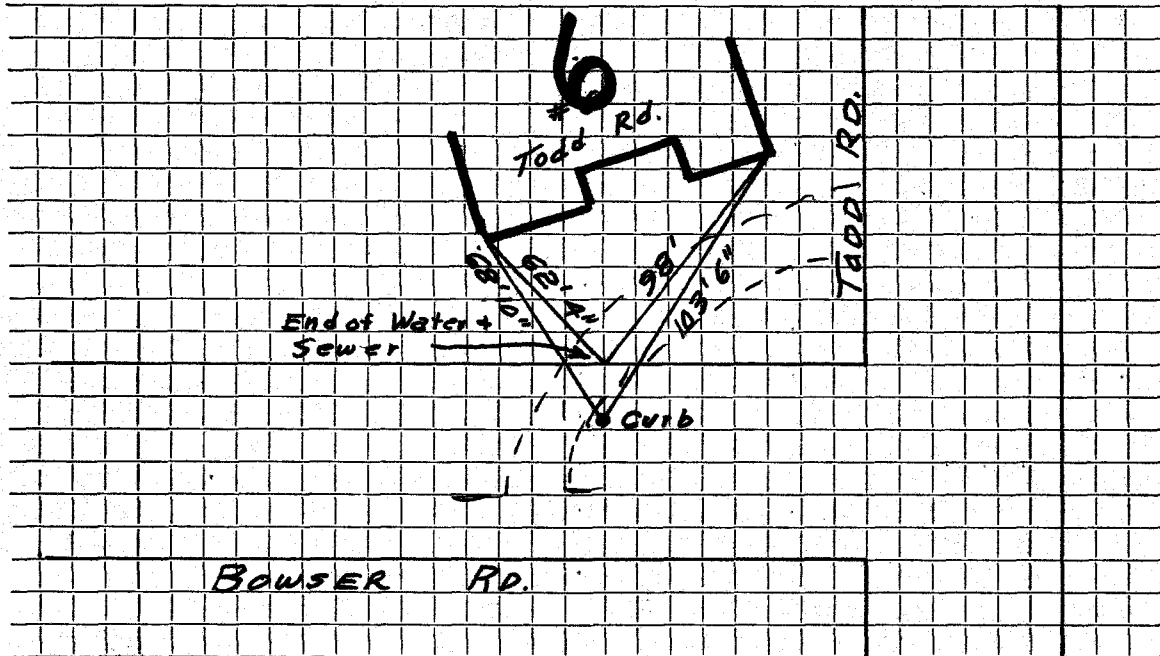

Connection made in Street. Work completed

Remarks:

.....

.....