

## WATER SERVICE RECORD

#5606

Name Donald Jenkins

Service No. 96

Address 7 Todd Road

Location Lot #25 Sta. 6+08 El. 180.08

Repair—Renewal—New Service

W.O.# 7492


Comm 10-29-62

Date	Material	Amount	Total	Date	Material	Amount
6-23-62	Labor	2.13		7-27-62	Deposit	50.00
	10% O.H.	.21	2.34	10-29-62	Paid by SH C# 114	2.98
	11' 3/4" Copper tubing @.42		4.62			57.98
	1 hr. Trucking @3.00		3.00			
	BILL WHEN CONNECTED		9.96		NON CHARGE	
8-6-62	Labor	4.26		6-23-62	Labor	2.13
	10% O.H.	.43	4.69		23' 3/4" Copper tubing @.42	9.66
	77' 3/4" Copper tubing @.42		32.34		1 3/4" C Corp Cock	4.91
	1 3/4" CX 1/2 I.W.H. Stop & Waste		6.17		1 3/4" C Curb Cock	6.28
	2 3/4" C Union Part @2.41		4.82		1 Box & Rod	4.90
			57.98			27.88
				8-6-62	1 1/2 Straight Tailpiece	.50
					1 1/2 Offset Tailpiece	.50
						28.88

DATE \_\_\_\_\_

TOWN OF LEXINGTON — BOARD OF PUBLIC WORKS  
WATER DIVISION

Sketch of Service Here

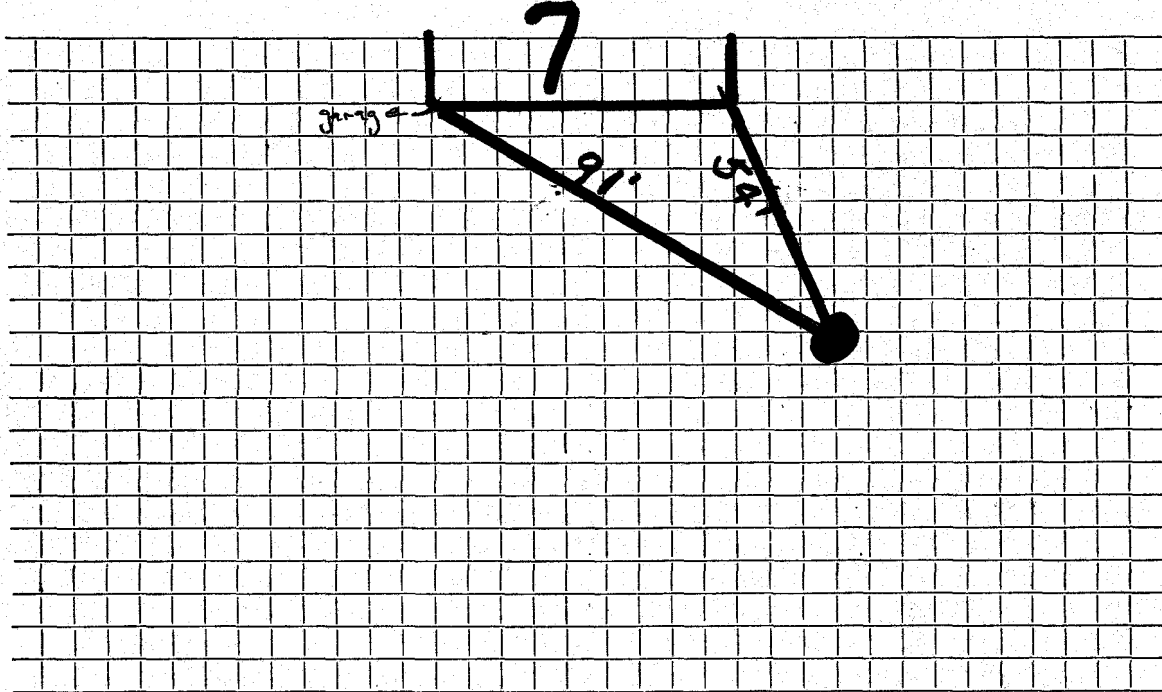

Connection made in ..... Street. Work completed .....

Remarks: .....

.....

.....