

Name Custance Bros.

Service No. ~~70~~ 2678

Address ~~59 Bedford St.~~

#7075

10 Tower Rd

Location ^{#10} Lincoln C. & Anna Grush Tower Street

Kind of Pipe

Size

Size of Main

~~Repairs-Renewal~~ New Service

Location

Date	Material	Amount	Total	Date	Amount
------	----------	--------	-------	------	--------

P. 12-22-31
for
26-25

35'	1" C.L. Pipe @.27	9 45	
3	1" L.L.C up. @.25	75	
1	1" L.L. Ell	30	
1	1" Br. Sp. Nip.	25	
1	S & W	3 00	
	Trucking	75	14 50

A.R. 2-24-32 Nov. 12, 1935 - Abated 26 25
A.R. 6-15-32
A.R. 9-15-32
12-19-32
A.R. 4-26-33
A.R. 3-20-34

Hadley Press, Inc. Lexington

11/14/31	7 Hrs. Labor @.55	3 85	
	3 " " @.60	1 80	5 65
	15% Overhead		85
	COST		21 00

CHARGE	35 ft. @ .75	\$26 25	\$26 25
---------------	--------------	---------	---------

K

TOWN OF LEXINGTON—BOARD OF PUBLIC WORKS
WATER DIVISION

The undersigned applies for a supply of water at No. Tower St. St. and hereby agrees to comply with the rules and regulations as now, or at any future time, established by the Board of Selectmen.

Am't. of Estimate \$ _____

Owner

Lincoln C & Anna Gush


Am't. Paid \$ _____

Address

Lowe Street
Lowell Lexington

Builder _____

Sketch of Service Here

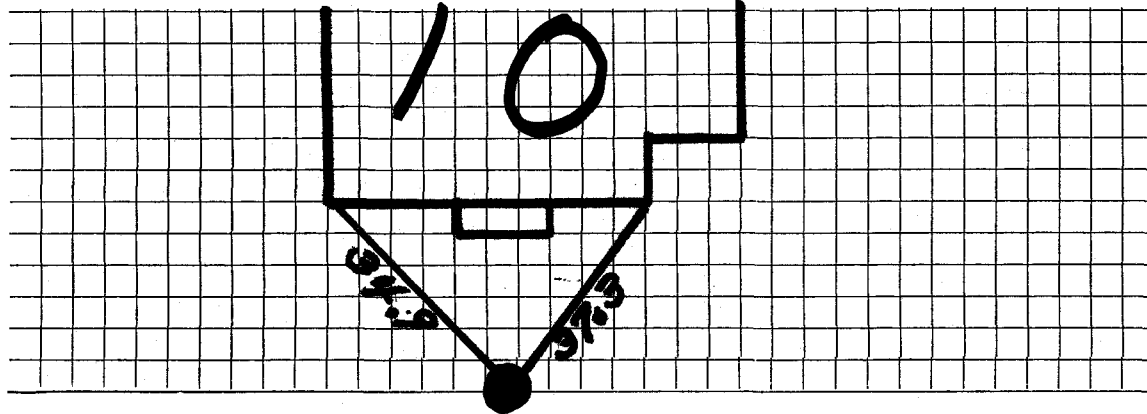

Connection made in _____ Street.

Work completed _____ 19

Remarks: