

Name Custance Bros.

Service No. **2679**

Address

~~54 Bedford St., Lexington~~

*12 Tower St* Location *12* ~~57~~ Tower St.

Kind of Pipe

Size

Size of Main

~~Repairs - Renewal~~ - New Service

Location

Date	Material	Amount	Total	Date	Amount
<i>Comm. 39.-</i>	52 1" C.L. Pipe @ .27	\$14 04			
<i>6-21-32</i>	2 1" L.L. Coup. @ .15	30		<i>Check 11 1932 Abate</i>	
<i>Comm. 39.-</i>	1 1" Br. C. Nip.	15		<i>July 21, 1934 - Cash -</i>	<u>39 00</u>
<i>8-16-32</i>	1 S & W	3 00			
	Trucking	75	18 24	<i>A.R. 9-15-32</i>	
				<i>1279-32</i>	
<i>1-21/32</i>	7 Hrs. Labor @ .55	3 85		<i>A.R. 4-26-33</i>	
	3 " " @ .60	1 80	5 65	<i>A.R. 3-30-34</i>	
	15% Overhead		85		
<u>COST</u>			24 74	<i>3/02</i>	<i>3/1 copper</i>
<u>CHARGE</u>	52 Ft. @ .75 pr. ft.	\$39 00	\$39 00		
	<i>Let this include 3.00 con. charge.</i>				
	Labor			<i>1 copper to iron</i>	
				<i>1 lead to copper</i>	

H. Gray Press, Inc., Lexington

DATE April 13-32

# TOWN OF LEXINGTON—BOARD OF PUBLIC WORKS

## WATER DIVISION

The undersigned applies for a supply of water at No. 12<sup>12</sup> 57 Lower St. and hereby agrees to comply with the rules and regulations as now, or at any future time, established by the Board of Selectmen.

Am't. of Estimate \$ \_\_\_\_\_

Owner

Theodore A Custard

Am't. Paid \$ \_\_\_\_\_


Address

54 Bedford Street

Lexington Mass

Builder \_\_\_\_\_

Sketch of Service Here

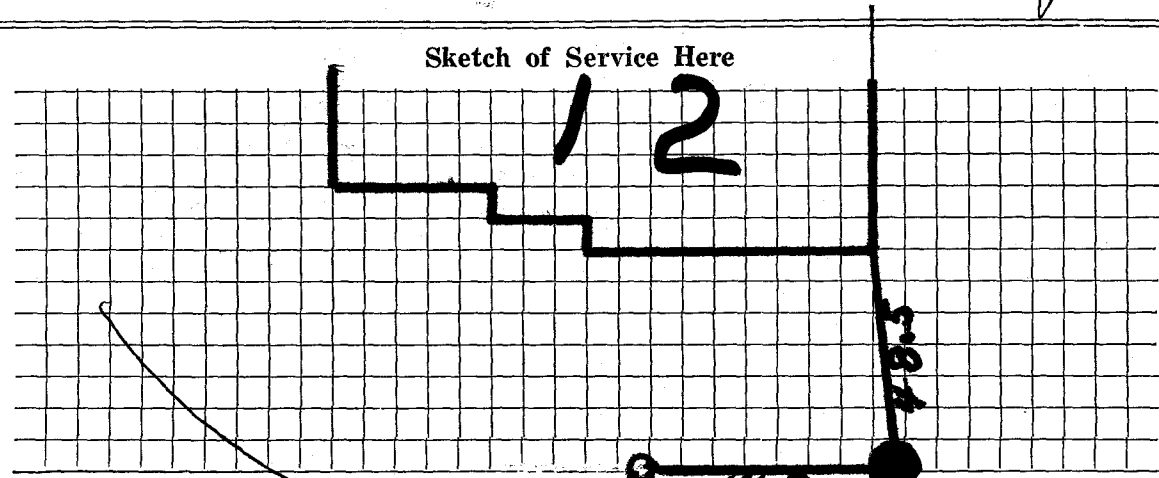

*copper service  
under new gas  
over old gas.  
1 ft from sewer  
manhole*

Connection made in \_\_\_\_\_

Street.

Work completed \_\_\_\_\_

19

Remarks:

