

WATER SERVICE RECORD

Name Herbert McConchie

Service No. 88

Address 14 Tower Road

Location

Repair—Renewal—New Service


Comm 9-24-56

Date	Material	Amount	Total	Date	Amount	
5/7/56	Labor	1 95		5-3-56	Deposit	50 00
	10% overhead	20	2 15	9-24-56	Refund	20 31
	45' 3/4" copper tubing @ .4850		21 83		<u>NON CHARGES</u>	29 69
	1 3/4" C x 1/2" I.W.H. stop&waste		1 96		Labor	1 95
	1 hr. trucking @ .75		75		17' 3/4" copper tubing @ .4850	8 25
			29 69		1 3/4" G Corp Cock	1 34
7-13-87	1 3/4 Comp Union				1 3/4" C Curb Cock	5 94
					1 Box & Rod	1 62
					1 1/2 Straight Tail Piece	50
					1 1/2 Offset Tail Piece	50
						26 10

TOWN OF LEXINGTON — BOARD OF PUBLIC WORKS

WATER DIVISION

Sketch of Service Here

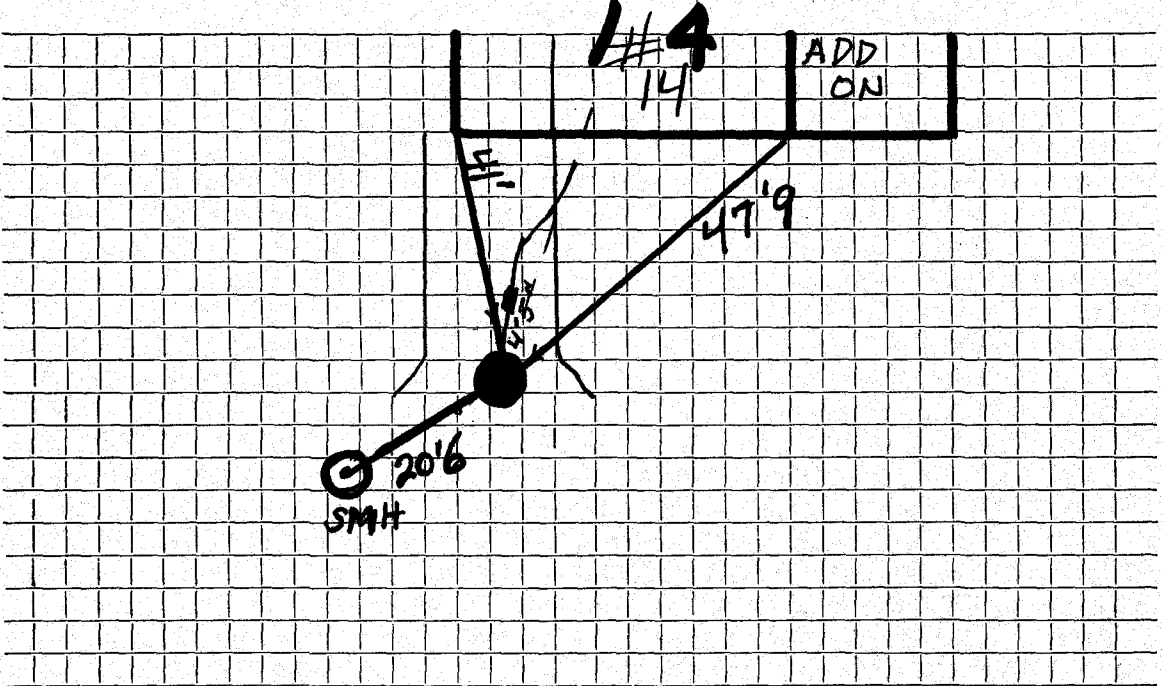

Connection made in Street. Work completed

Remarks: WATER OVER Sewer by wye

.....
.....