




DATE 11-13-01

TOWN OF LEXINGTON — BOARD OF PUBLIC WORKS

WATER DIVISION

Sketch of Service Here

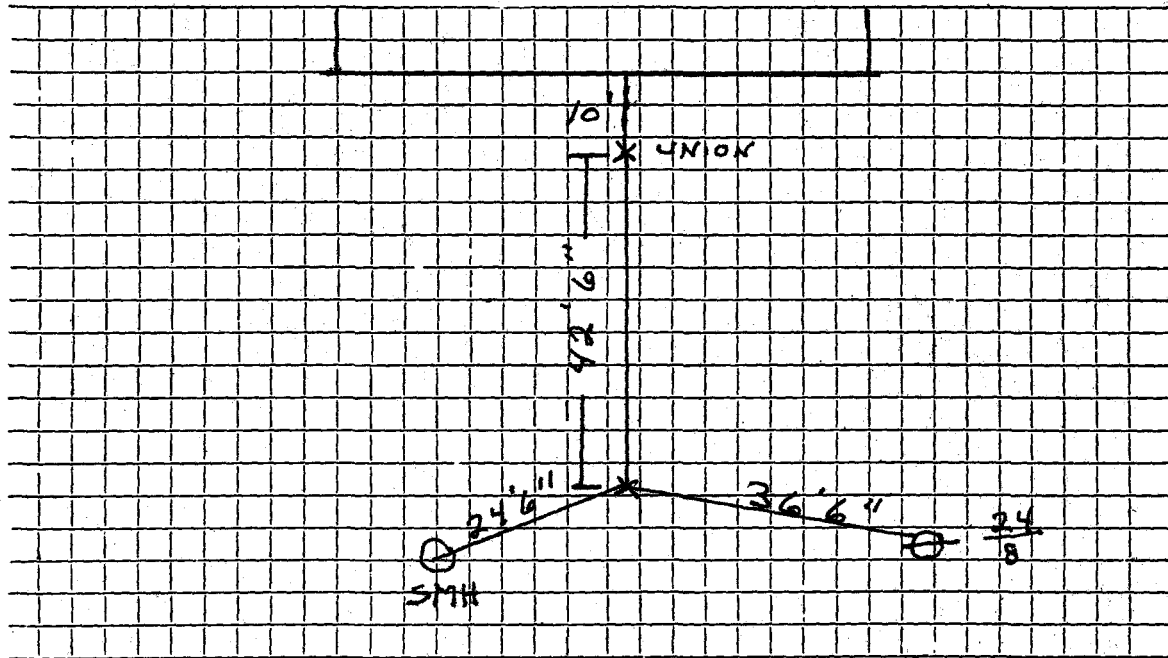

Connection made in ... TOWER Rd ... ~~Street~~ ... Work completed ... 11-13-01 .....

Remarks: INSTALLED BY KEVIN McIVER .....