

Name

1058
Service No. 2680

Address

21 Tower Rd

#7084

Location

21 Tower Rd.

Kind of Pipe

Size

Size of Main

Repair—Renewal—New Service

Location

Date	Material	Amount	Total	Date	Amount
					NON-CHARGE (Repair) W.O. #3824.
				10/15/75	Labor \$168.16
				40'	3/4" Copper @.67 26.80
				1	1" x 6" Iron Nipple .90
				1	3/4 Curb Stop 13.70
				1	1" x 3/4 Iron Bushing 1.72
				1	1" Style 38 Clamp 5.25
				1	Curb Box & Rod 15.40
				1	Lead to Copper Bushing 1.72
	Labor			2	Hrs. Trucking @3.00 6.00
				6	Hrs. Town Shovel @6.50 39.00
				1	8'x 8'x 1" Patch 43.00
				1	16'x12'x1" Patch 132.00
					<u>\$453.65</u>

DATE _____

TOWN OF LEXINGTON—BOARD OF PUBLIC WORKS

WATER DIVISION

The undersigned applies for a supply of water at No. _____ St. and hereby agrees to comply with the rules and regulations as now, or at any future time, established by the Board of Selectmen.

Am't. of Estimate \$ _____

Owner

R. W. Milliken


Am't. Paid \$ _____

Address

21 Tower Rd.

Builder _____

Sketch of Service Here

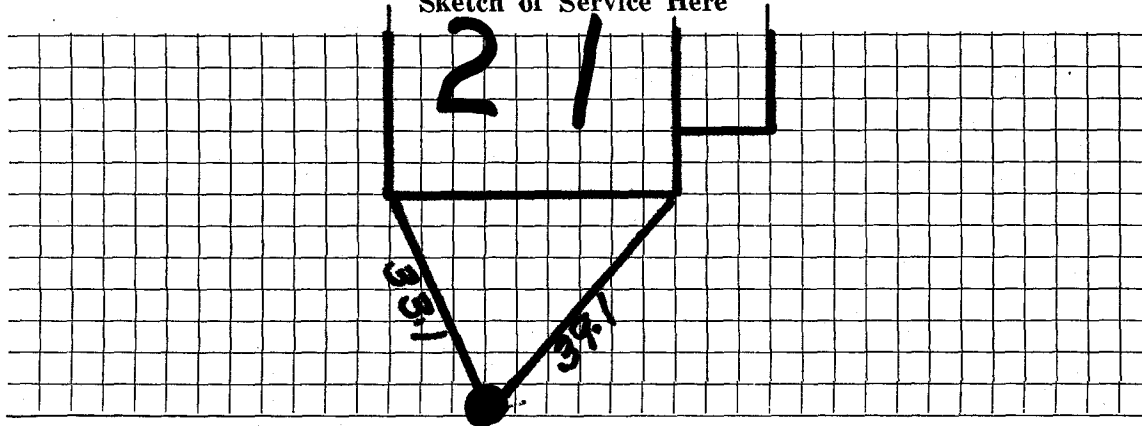

Connection made in _____ Street.

Work completed _____ 19

Remarks: