

Name Chester Earle

2143
Service No. 32682 ✓

Address 29 Tower Road

Location 29 Tower Road

Kind of Pipe

Size

Size of Main

~~Repair~~ - Renewal - ~~NEW SERVICE~~

Location

Date	Material	Amount	Total	Date	Amount
Jan. 14, '46	Labor	29 44	29 44	Jan. 12, '46	50 00
	10% Overhead		2 94	Jan. 24, '46	87
	66' - $\frac{3}{4}$ " Copper Tubing		12 61		49 13
	1 - $\frac{3}{4}$ " C x $\frac{1}{4}$ " I.W.H. Stop & Waste		2 35		
	1 - $\frac{3}{4}$ " C. Union (3 parts)		1 04	Jan. 14, '46	39 73
	Trucking 1 hr.		75	21' - $\frac{3}{4}$ " Copper Tubing	4 01
			49 13	1 - 5/8" C. Adapter	1 18
				1 - $\frac{3}{4}$ " C x $\frac{3}{4}$ " C. Curb-cock	3 02
				3.50 Tons Bank Gravel @.50	1 75
				Comp. 2 hrs. @1.75	3 50
				Trucking 3 hrs. @.75	2 25
					55 44
	Labor				

Deposited
Refunded

Non-Charge

Com 1-21-46

Hadley Press, Inc., Lexington

DATE _____

TOWN OF LEXINGTON—BOARD OF PUBLIC WORKS

WATER DIVISION

The undersigned applies for a supply of water at No. _____ St. and hereby agrees to comply with the rules and regulations as now, or at any future time, established by the Board of Selectmen.


Am't. of Estimate \$ _____

Owner _____

Am't. Paid \$ _____

Address _____

Builder _____

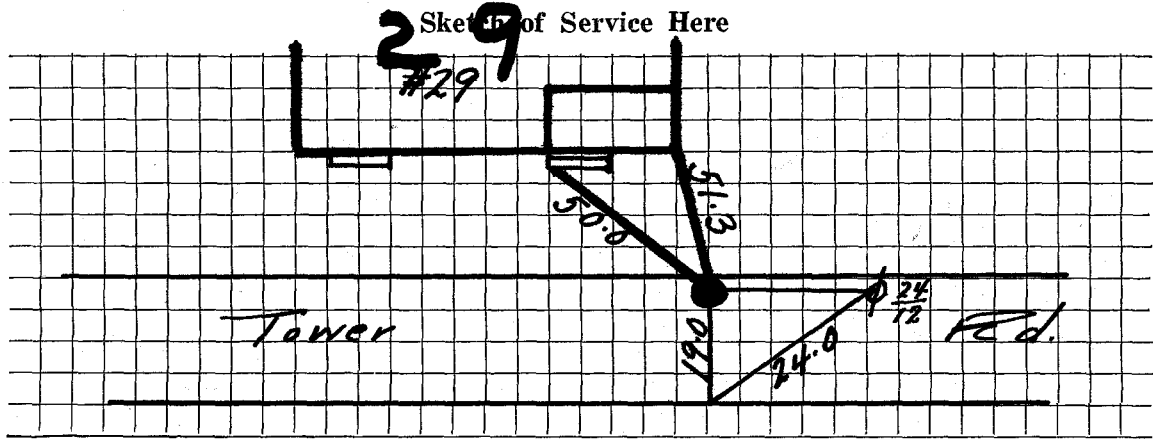

Connection made in _____ Street.

Work completed _____ 19

Remarks: