

## WATER SERVICE RECORD

# 5710

Name **Joseph Chisholm**Service No. **156**Address **30 Tower Road, Lexington, Mass.**

Location


~~Repairs~~ ~~Renewal~~ **New Service**

Comm. 10-28-57

Date	Material	Amount	Total	Date	Amount	
8-5-57	Labor	1 76		7-30-57	Deposit	\$ 50 00
	10% overhead	18	1 94	10-28-57	Refund	36 77
15' 3/4" Copper tubing @ .375		5 63				+ 13 25
1 3/4" Cx I W H stop & waste		4 96			NON CHARGE	
1 hr. trucking @ .75		75	11 34		Labor	3 62
			13 28	15' 3/4" Copper tubing @ .375		5 63
				1 3/4" C Corp Cock		4 64
				1 3/4" C Curb Cork		5 94
				1 Box & Rod		4 62
				1 1/2 Straight tail piece		50
				1 1/2 Offset tail piece		50
						25 45
				5-5 80 12 1/4" 3/4 Copper		

TOWN OF LEXINGTON — BOARD OF PUBLIC WORKS  
WATER DIVISION

Sketch of Service Here

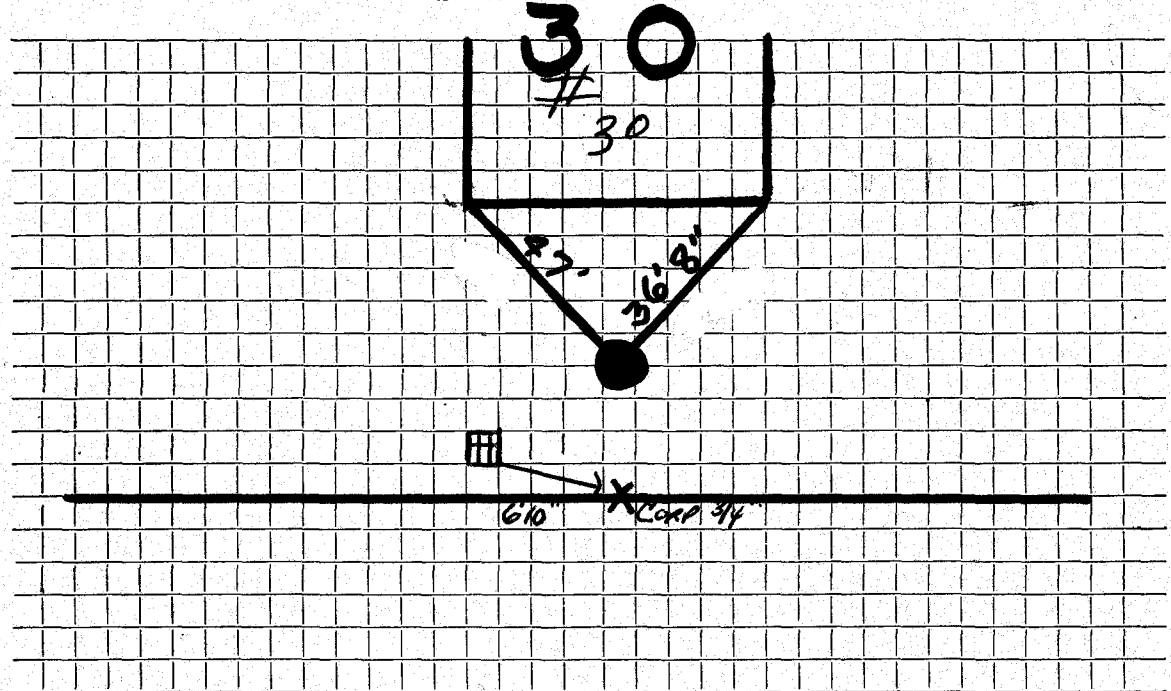

Connection made in ..... Street. Work completed .....

Remarks: WATER + Sewer side by side same trench about 3' deep by walk .....

12-11-85 dug inside could NOT locate Leak

5-5-86 LEAK REPAIRED - SPLIT ABOVE DRAIN PIPE - INSTALLED 12' 3/4" Cap