

## WATER SERVICE RECORD

Name Mac L &amp; B Realty Co.

Service No. 49

Address 32 Tower Road

Location

~~XXXXXXXXXXXX~~ New Service W.O. # 9079

DeFlac #1753

DEC 31 1970


Date	Material	Amount	Total	Date	Amount
11/5/70	Labor		14 32	10-14-70	Deposit 75 00
	10% O.H.		1 43	1-18-71	Refund 16 04
18!	3/4" Copper pipe .79		14 22		58 96
	3/4" Corporation		9 57		
	3/4" Curb cock		11 32		
	Box & Rod		5 10		
1	Hr. Trucking		<u>3 00</u>		
			58 96		
11-10-70 32'	3/4" Copper tubing				

DATE \_\_\_\_\_

# TOWN OF LEXINGTON -- BOARD OF PUBLIC WORKS

## WATER DIVISION

Sketch of Service Here

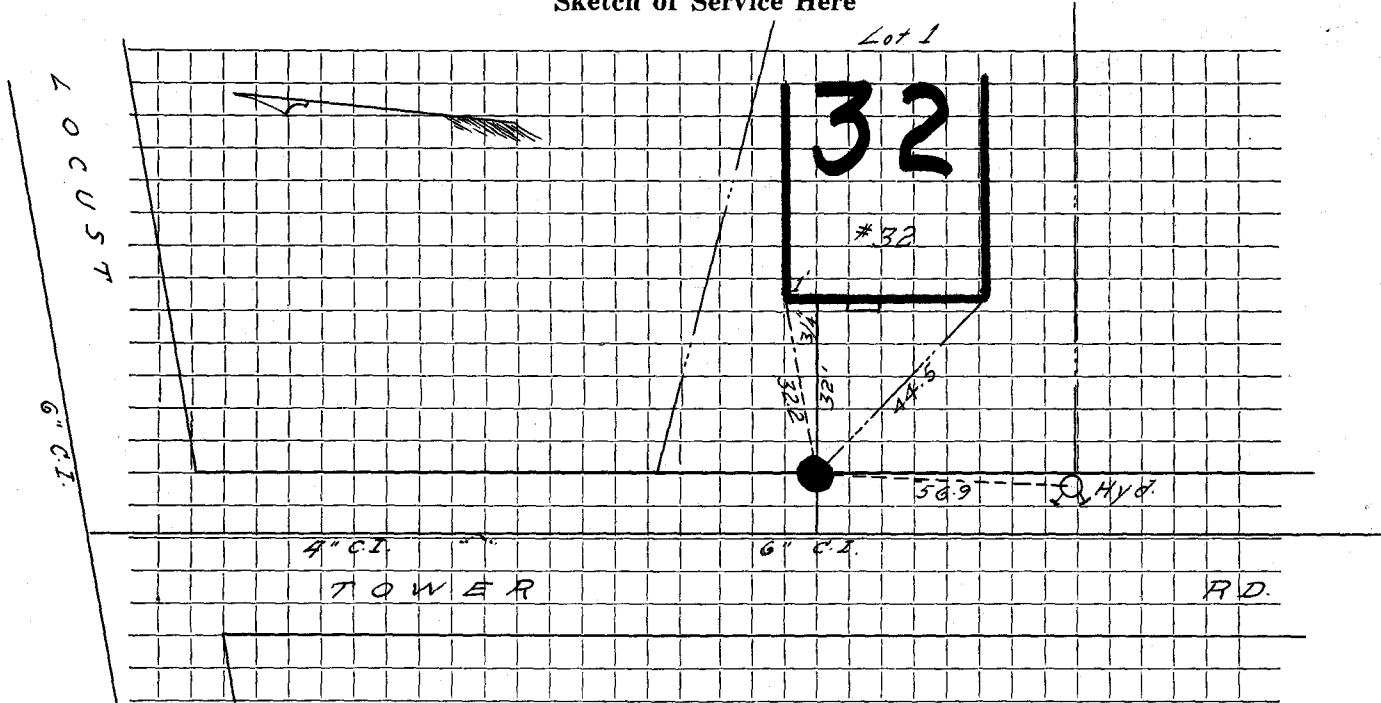

Connection made in ..... Street. Work completed .....

Remarks: .....  
.....  
.....