

Name Arthur Bennett

Service No.

282  
#4766

Address 36 Tower Road

Lexington, Mass.

Location 36 Tower Road

Kind of Pipe

Size

Size of Main

~~Repair~~ ~~Renewal~~ New Service

Location

Date	Material	Amount	Total	Date	Location	Amount
Dec. 8, '48	Labor	1 15	1 15	Nov. 26 '48	Revised	20 00
	10% Overhead		12	Dec. 31 '48	Refunded	5 60
	31' - 3/4" Copper Tubing @.255	7 91			Non-Charge	14 40
	1 - 3/4" C x 1/2" I.W.H. S&W	3 15		Dec. 8, '48	Labor	1 15
	1 - 3/4" C x 3/4" Union (3pts)	1 32			7' - 3/4" Copper Tubing @.255	1 79
	Trucking 1 hr. @.75	.75			1 - 3/4" C Corp-cock	3 00
			14 40		1 - 3/4" C x 3/4" C urb-cock	3 68
					1 - Box & Rod	3 55
					1 - 1/2" Straight Tail Piece	30
					1 - 1/2" Offset Tail Piece	30
					Trucking 1 hr. @.75	75
						14 52
	Labor					

DATE \_\_\_\_\_

TOWN OF LEXINGTON - BOARD OF PUBLIC WORKS

**WATER DIVISION**

The undersigned applies for a supply of water at No..... St. and hereby agrees to comply with the rules and regulations as now, or at any future time, established by the Board of Selectmen.

Am't of Estimate \$.....

Owner .....


Am't Paid \$.....

Address .....

Builder .....

.....

**Sketch of Service Here**

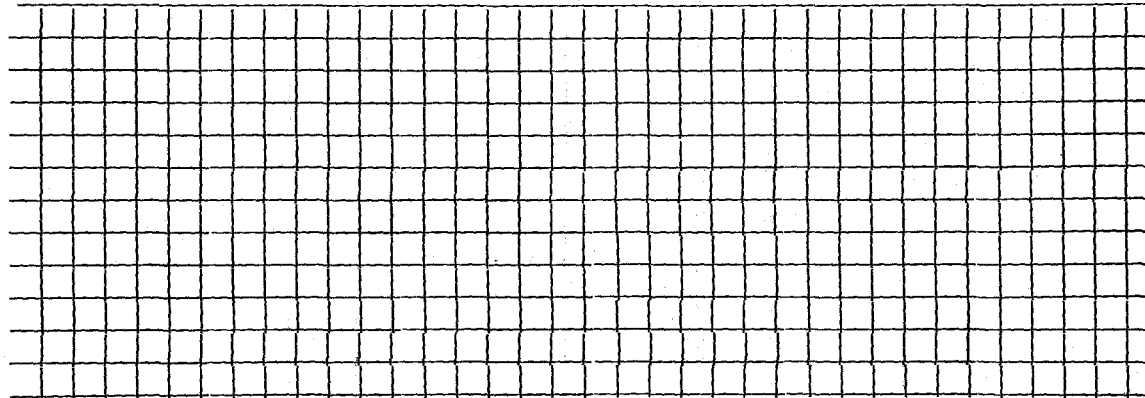

Connection made in ..... Street.

Work completed .....19

Remarks: