

Name H. W. Crydenwise (Deposit made by M.B.Judkins)

Service No. ~~1937 - # 7~~
 2085
 # 6713

Address 37 Tower Road

Location #37 Tower Road

Kind of Pipe Size Size of Main

~~Repair - Renewal~~ - New Service

Location

Date 1937	Material	Amount	Total	Date	Amount
Feb. 20	2 hrs. @ 60 ¢	1 20		2-9-37	24 00
Com 3-9-37	overhead	5 12	1 32	4-27-37	4 50
	57' 1" Copper pipe @ 25¢		14 25		18 50
	1 Stop and Waste		2 50		
	1 Union		50		
			18 57		
	Say: 57' @ 50¢		\$28 50	Bill sent 3-10-37 4:50	
	Labor				

Hadley Press, Inc., Lexington

DATE Feb 12, 1937

TOWN OF LEXINGTON—BOARD OF PUBLIC WORKS

WATER DIVISION

The undersigned applies for a supply of water at No. Fower Rd. St. and hereby agrees to comply with the rules and regulations as now, or at any future time, established by the Board of Selectmen.

Am't. of Estimate \$ _____

Owner H. W. Crydenwise


Am't. Paid \$ _____

Address Fower Rd. Lexington

Builder M B Jenkins

By M B Jenkins

Sketch of Service Here

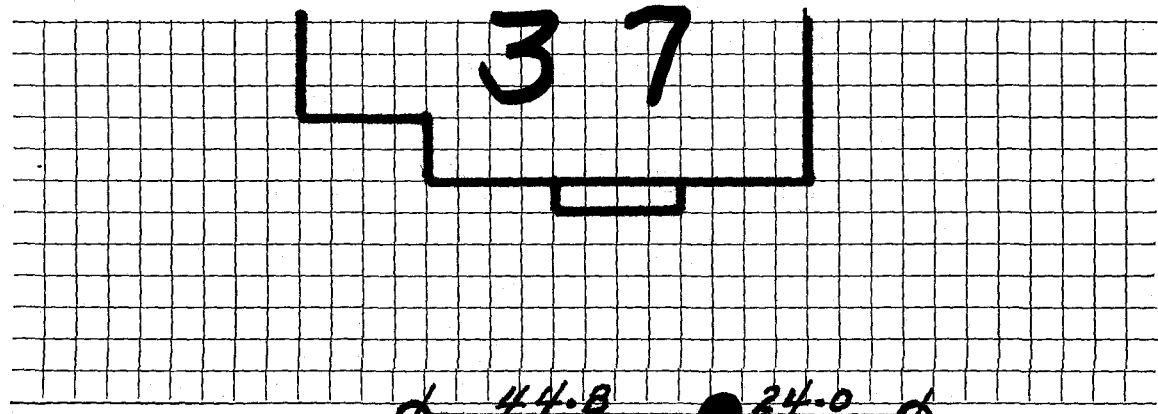

Connection made in _____

Street.

Work completed _____

19

Remarks: