

Name Arthur Bennett

Service No.

261

Address 40 Tower Road

Lexington, Mass.

Location 40 Tower Road

Kind of Pipe

Size

Size of Main

~~REPAIR-BENSWAY~~ New Service

Location

Date	Material	Amount	Total	Date	Amount
Dec. 6, '48	Labor	1 15	1 15	Oct. 29 '48	20 00
	10% Overhead		12	Dec. 31 '48	6 92
	31' - 3/4" Copper Tubing @ .255	7 91	7 91		13 08
	1 - 3/4" C x 1/2" I.W.H. S&W	3 15	3 15	Dec. 6, '48	Labor
	Trucking 1 hr. @ .75	75	75		1 15
			13 08		12' - 3/4" Copper Tubing @ .255
					3 06
					1 - 3/4" C Corp-cock
					3 00
					1 - 3/4" C x 3/4" C Corp-cock
					3 68
					1 - Box & Rod
					3 55
					1 - 1/2" Offset Tail Piece
					30
					1 - 1/2" Straight Tail Piece
					30
					Trucking 1 hr. @ .75
					75
					15 79
	Labor				

DATE \_\_\_\_\_

TOWN OF LEXINGTON - BOARD OF PUBLIC WORKS

**WATER DIVISION**

The undersigned applies for a supply of water at No..... St. and hereby agrees to comply with the rules and regulations as now, or at any future time, established by the Board of Selectmen.

Am't of Estimate \$.....


Owner .....

Am't Paid \$.....

Address .....

Builder .....

Sketch of Service Here

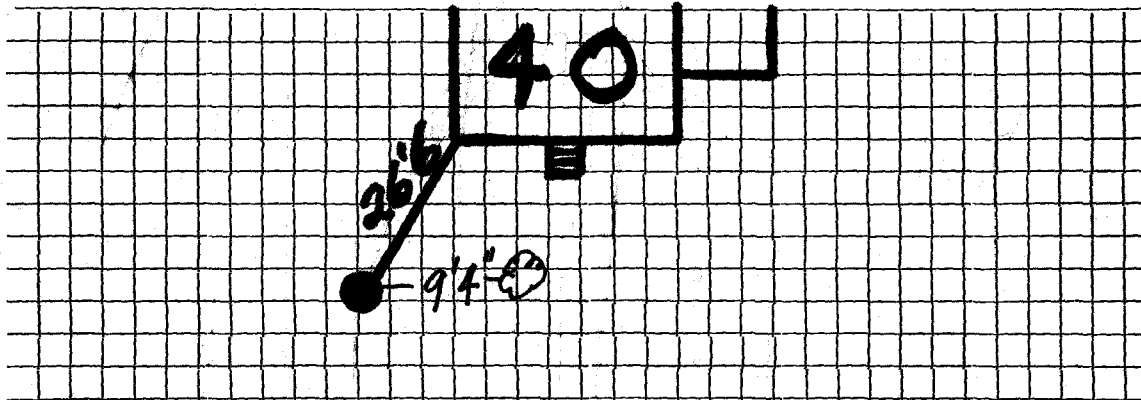

Connection made in ..... Street.

Work completed .....19

Remarks: