

Name James R. Smith

Service No. ( 2677 )

Address 154 Highland Ave., Arlington

#9 Tower Rd

# 442

9 Tower Rd

Location

Lot # 11A Tower St.

Kind of Pipe

Size

Size of Main

~~Repair - Renewal~~ - New Service

Location

Date	Material	Amount	Total	Date	Amount
------	----------	--------	-------	------	--------

3/28/33-28	5/4" Copper Pipe @.12	\$ 3 36			
------------	-----------------------	---------	--	--	--

Comm. 16.80 6-28-33	1 S & W	2 75			
------------------------	---------	------	--	--	--

	Trucking	75	\$6 86		
--	----------	----	--------	--	--

7	Hrs. Labor @ .55	3 85			
---	------------------	------	--	--	--

2	" " @ .50	1 00	4 85		
---	-----------	------	------	--	--

	15% Overhead		73		
--	--------------	--	----	--	--

<u>COST</u>			\$12 44		
-------------	--	--	---------	--	--

<u>CHARGE</u>	28 @ .50	\$16 80	\$16 80		
---------------	----------	---------	---------	--	--

July 27, 1935 Cash

16 80

Labor

Hadley Press, Inc., Lexington

Trench by owner

DATE March 28, 1933

# TOWN OF LEXINGTON—BOARD OF PUBLIC WORKS

## WATER DIVISION

The undersigned applies for a supply of water at No. \_\_\_\_\_, Tower \_\_\_\_\_ St. and hereby agrees to comply with the rules and regulations as now, or at any future time, established by the Board of Selectmen.

Am't. of Estimate \$ \_\_\_\_\_

Owner

*James R. Smith*

Am't. Paid \$ \_\_\_\_\_


Address

154 Highland Ave.

Builder \_\_\_\_\_

Arlington, Mass.

Sketch of Service Here

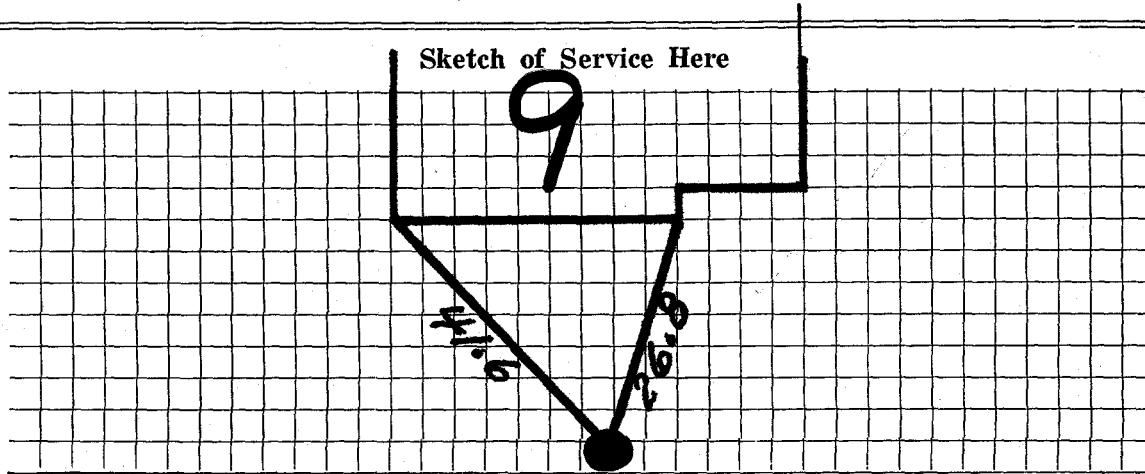

Connection made in \_\_\_\_\_ Street.

Work completed \_\_\_\_\_ 19

Remarks: