


DATE 8/11/76

TOWN OF LEXINGTON — BOARD OF PUBLIC WORKS

WATER DIVISION

Sketch of Service Here

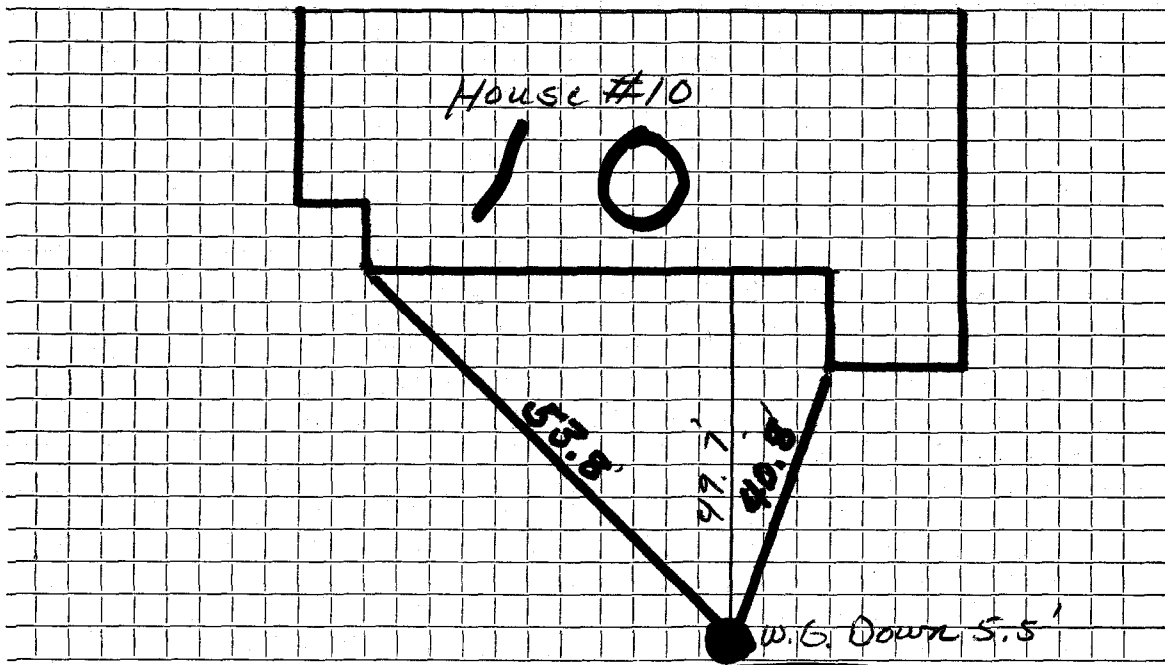

Connection made in Street. Fricorne Rd. Work completed

Remarks:
.....
.....