


TOWN OF LEXINGTON — BOARD OF PUBLIC WORKS

WATER DIVISION

Sketch of Service Here

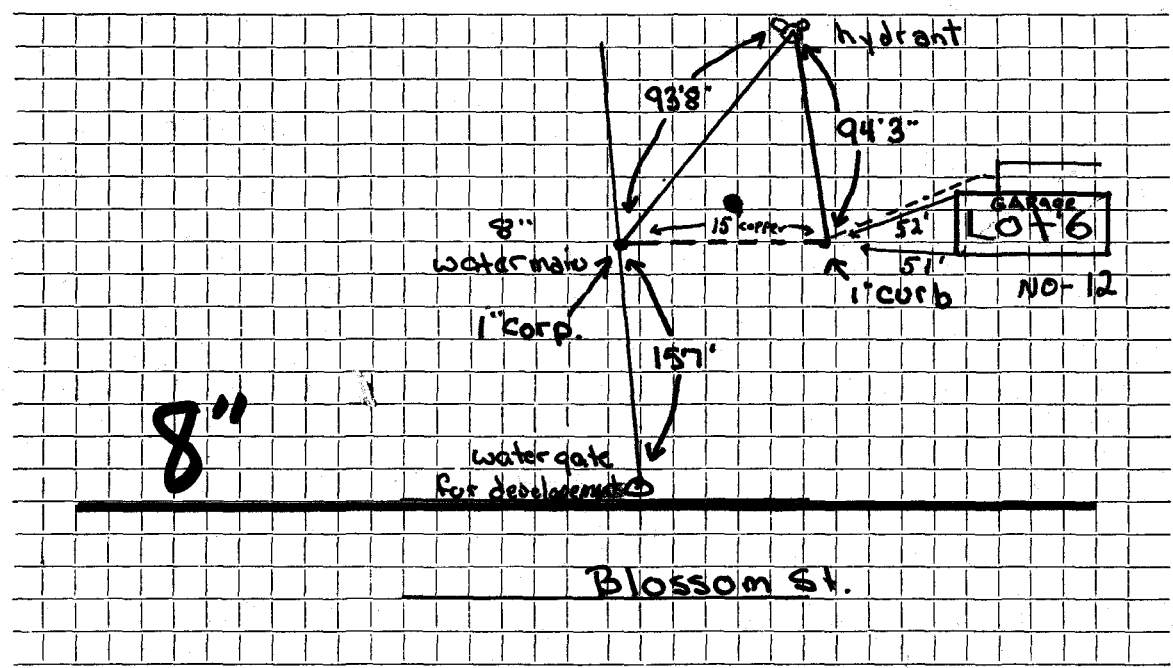

Connection made in MAIN. Commencing from Blossom St. Street.

Work completed

Remarks:

.....

.....