


DATE 7-16-81

TOWN OF LEXINGTON — BOARD OF PUBLIC WORKS

WATER DIVISION

Sketch of Service Here

2

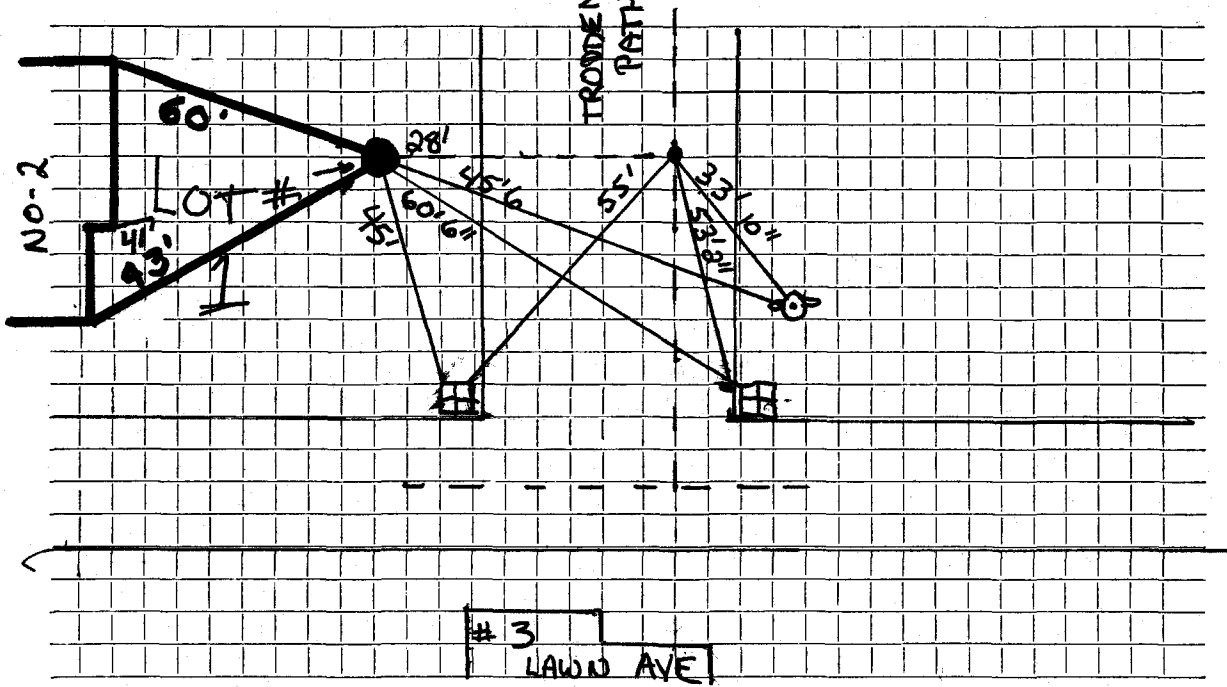

Connection made in Street. Work completed

Remarks: 28' 1" Copper