




DATE 7-16-81

TOWN OF LEXINGTON — BOARD OF PUBLIC WORKS

WATER DIVISION

Lot #2 - NO-4

Sketch of Service Here

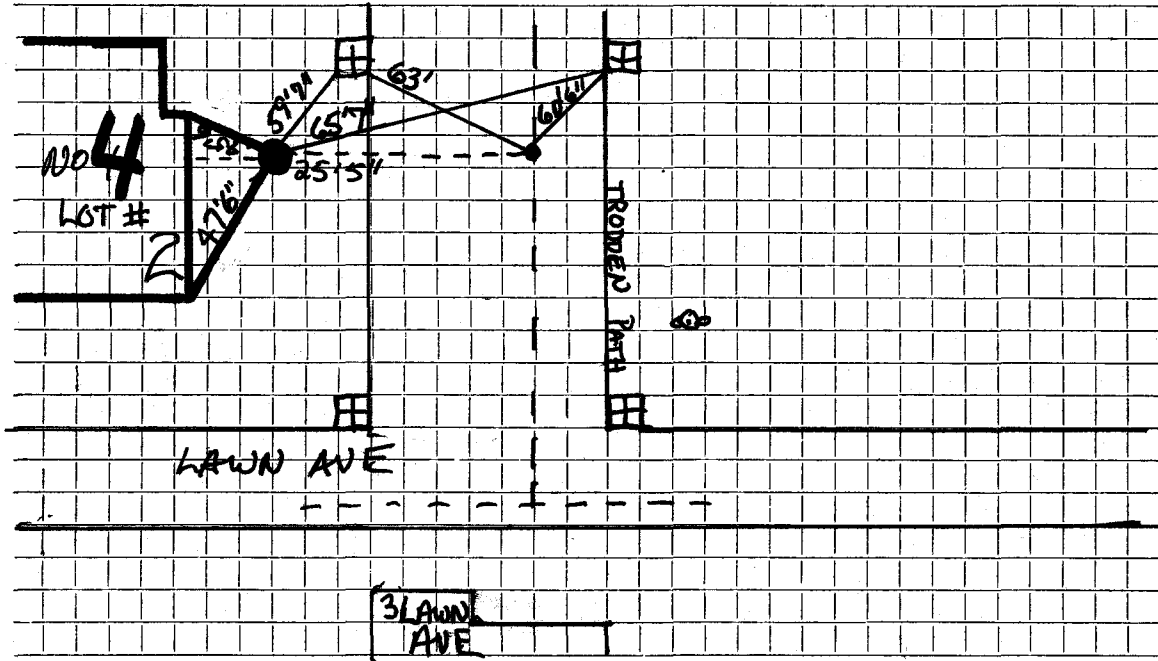

Connection made in ..... Street. Work completed .....

Remarks: 25'5" - 1" Copper out 4 1/2" IN .....