

WATER SERVICE RECORD

Name **J. G. Builders**

Service No.

Address **5 Trodden Path**

Location **Lot #10**


~~XXXXXX~~ **New Service Melone #3664**

Date	Material	Amount	Total	Date	Amount
8/14/81	37'	1" Copper tubing			
	1	1" Comp. Union			
					OUTSIDE
				8/14/81	17'
					1" Copper tubing
					1
					1" Curb
					1
					1" Corp.
					1
					Box & Rod

TOWN OF LEXINGTON — BOARD OF PUBLIC WORKS

WATER DIVISION

Sketch of Service Here

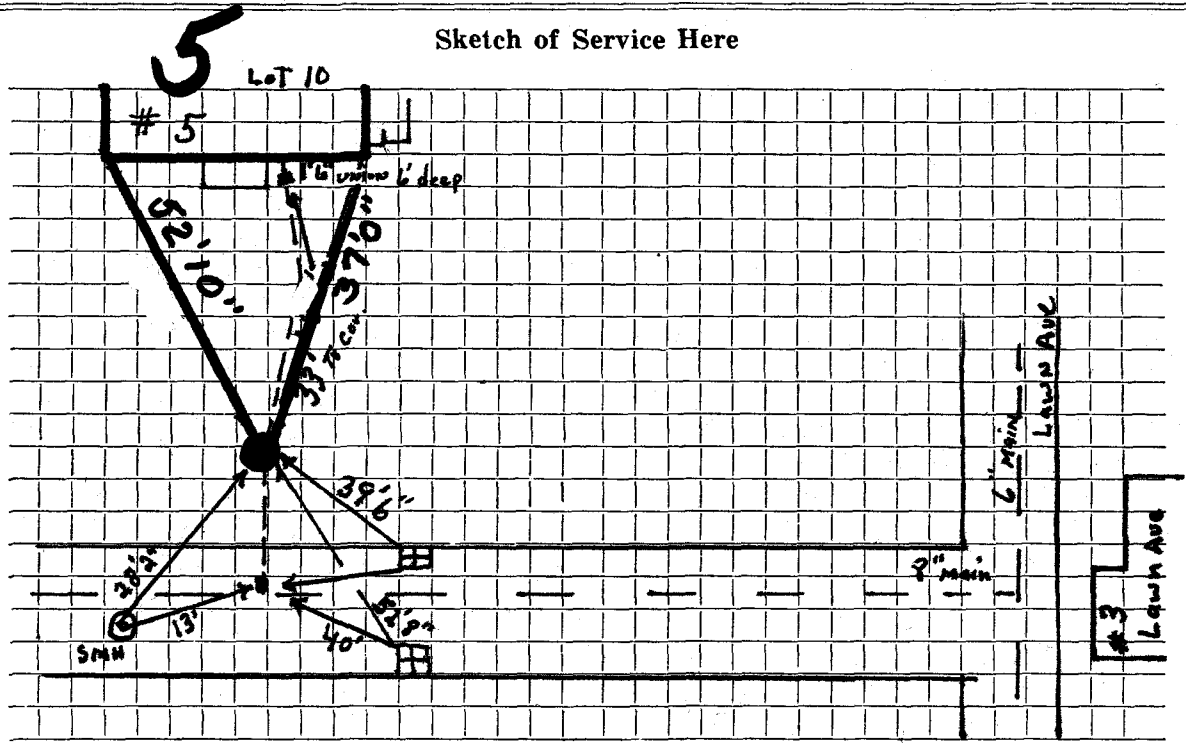

Connection made in Street. Work completed

Remarks:
.....
.....