




DATE JUNE 1983

TOWN OF LEXINGTON — BOARD OF PUBLIC WORKS

WATER DIVISION

Sketch of Service Here

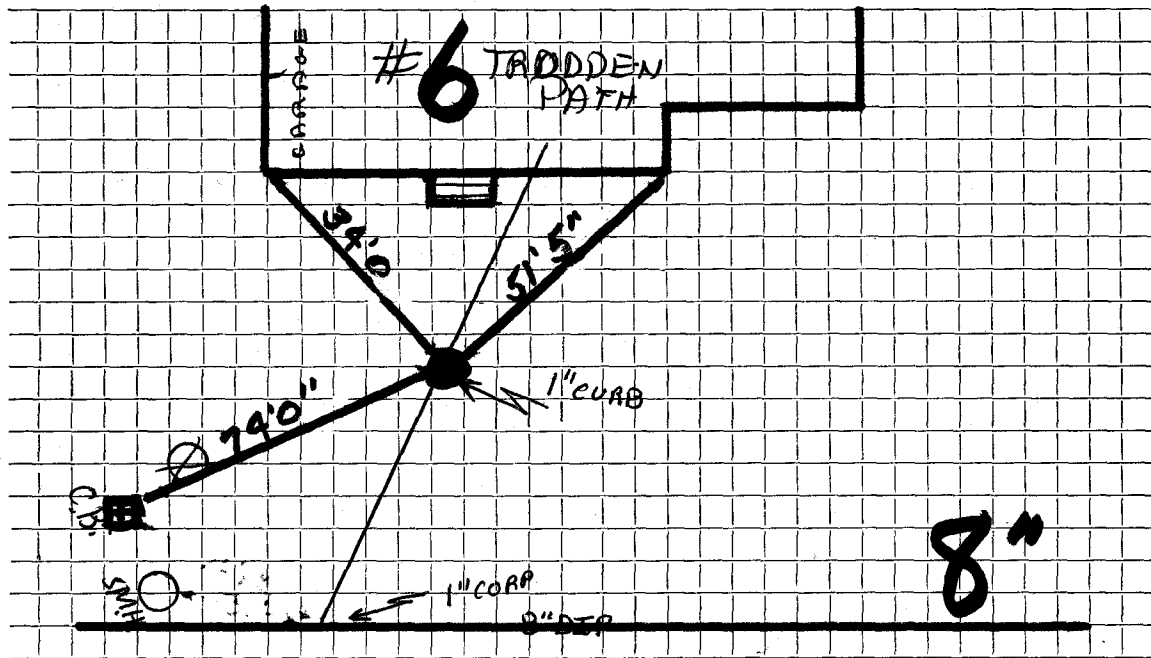

Connection made in TRODDEN PATH..... Street.

Work completed JUNE 10, 1983.....

Remarks: .....

.....

.....