

## WATER SERVICE RECORD

Name

Service No.

Address 10 Trotting Horse Drive (lot 27)

Location

Repair—Renewal—New Service

SERVICE IN TO CURB:

| Date     | Material   | Amount | Total | Date                                      | Amount            |
|----------|--|--------|-------|---|-------------------|
| 10-14-55 |  |        |       |   |                   |
|          | 135' $\frac{3}{4}$ " Copper                                  |        |       |   |                   |
|          | 1 $\frac{3}{4}$ " C. X $\frac{1}{2}$ " l.o.w.h. Stop + Waste |        |       |   |                   |
|          | 2 $\frac{3}{4}$ " X $\frac{3}{4}$ " UNIONS                   |        |       |   |                   |
|          |  |        |       |   | <u>NON CHARGE</u> |
|          |  |        |       | 10/11/54 Labor                            | 3 93              |
|          |  |        |       | 22' - $\frac{3}{4}$ " copper tubing @ .35 | 7 70              |
|          |  |        |       | 1 - $\frac{3}{4}$ " C. corp-cock          | 4 33              |
|          |  |        |       | 1 - $\frac{3}{4}$ " C. curb-cock          | 4 67              |
|          |  |        |       | 1 - box and rod                           | 3 90              |
|          |  |        |       | 1 hr. trucking                            | 75                |
|          |  |        |       |   | <u>25 88</u>      |


DATE \_\_\_\_\_

# TOWN OF LEXINGTON — BOARD OF PUBLIC WORKS

## WATER DIVISION

Sketch of Service Here

W. S. FOR # 10

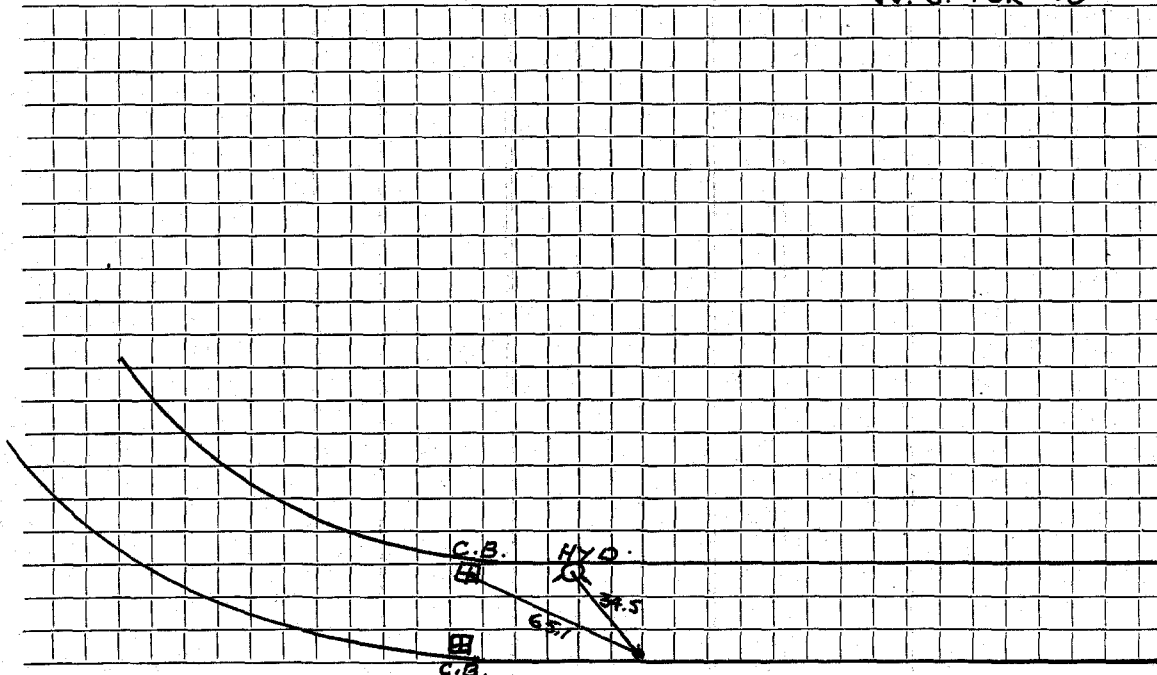

Connection made in ..... Street. Work completed .....

Remarks: .....

.....

.....