

WATER SERVICE RECORD

Name

Service No.

Address 12 Trotting Horse Drive (lot 28)

Location

~~NEW SERVICE~~ - New Service

SERVICE IN TO CURB:

Date	Material	Amount	Total	Date	Amount
6-11-56					
	75' $\frac{3}{4}$ " Copper				
	1 $\frac{3}{4}$ " C. X $\frac{1}{2}$ " I. W. H. Stop + Waste				
	1 $\frac{3}{4}$ " C. 3 Part Union				
					<u>NON CHARGE</u>
				10/11/54 Labor	3 93
				22' - $\frac{3}{4}$ " copper tubing @ .35	7 70
				1 - $\frac{3}{4}$ " C. corp-cock	4 33
				1 - $\frac{3}{4}$ " C. curb-cock	4 67
				1 box and rod	3 90
				1 hr. trucking	75
					25 28


DATE _____

TOWN OF LEXINGTON — BOARD OF PUBLIC WORKS.

WATER DIVISION

Sketch of Service Here

W.S. FOR #12

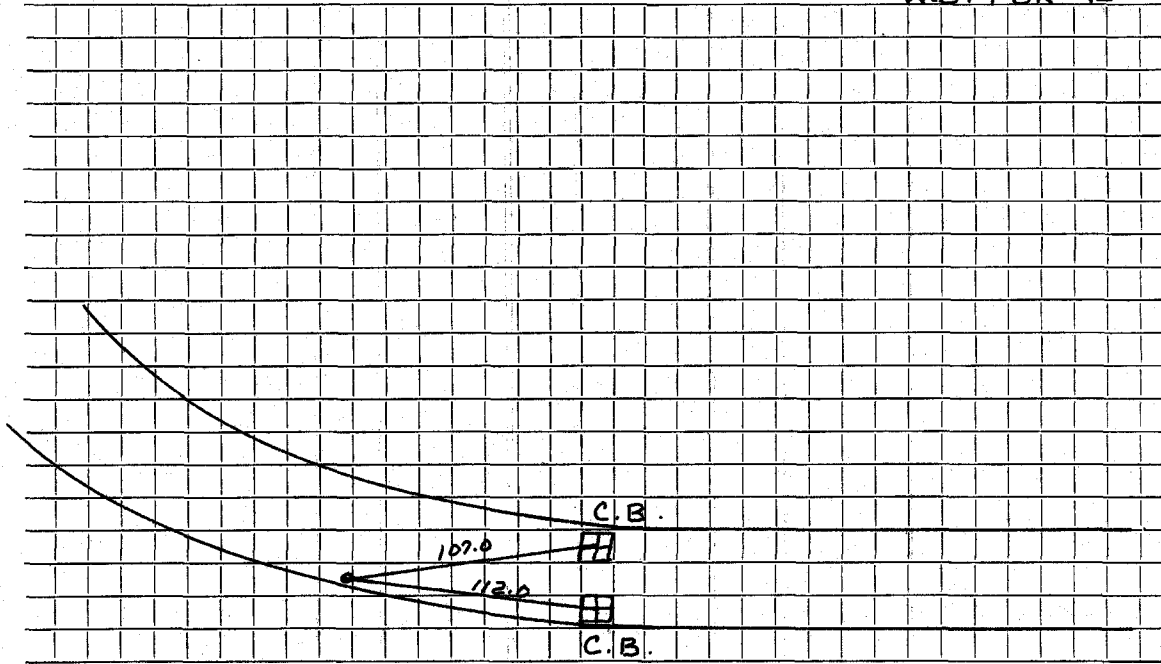

Connection made in Street. Work completed

Remarks:

.....

.....