

WATER SERVICE RECORD

Name

Service No.

Address 14 Trotting Horse Drive (lot 30)

Location

Repair—Renewal—New Service

SERVICE IN TO CURB:

Date	Material	Amount	Total	Date	Amount
6-1-56	120' 3/4" Copper				
	1 3/4" C. X 1/2" I.W.H. Stop + Waste				
	1 3/4" C. 3 Part Union				
					<u>NON CHARGE</u>
				10/11/54 Labor	3 93
				22' - 3/4" copper tubing @ .35	7 70
				1 - 3/4" C. corp-cock	4 33
				1 - 3/4" C. curb-cock	4 67
				1 box and rod	3 90
				1 hr. trucking	75
				10-7-64' Repair	25 28
				6' 3/4" Copper	
				1 3/4" C. Curb Cock	
				1 3/4" Style 88 Coupling	


DATE _____

TOWN OF LEXINGTON - BOARD OF PUBLIC WORKS

WATER DIVISION

Sketch of Service Here

W.S. FOR # 14

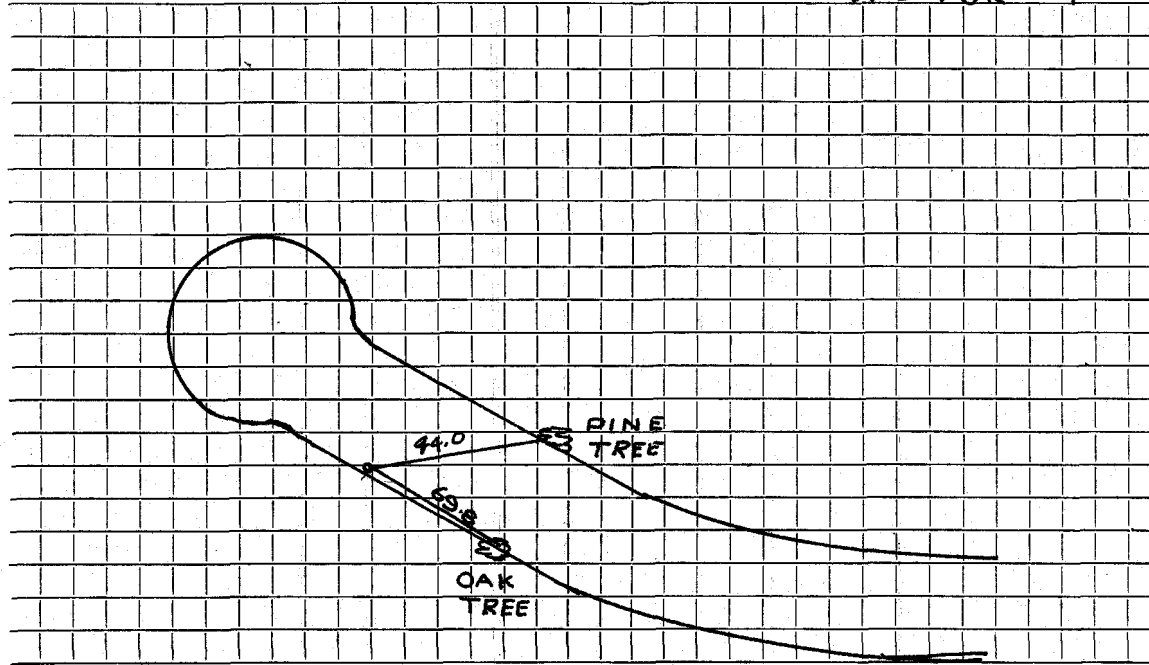

Connection made in Street. Work completed

Remarks:

.....

.....