

WATER SERVICE RECORD

Name

Service No. 213

Address 15 TROTting HORSE DRIVE

Lot 32

Location

Repair—Renewal—New Service

Date	Material	Amount	Total	Date	Amount
7-6-56					
	120' 3/4" COPPER TUBING				
	1 3/4" x 1/2" I.W.H STOP + WASTE				
	1 3/4" C UNION 3 PART			10' 3/4" COPPER TUBING	
				1 3/4" C CORP - COCK	
4-29-65	REPAIR			1 - 3/4" CORP - COCK	
	2' 3/4" COPPER			1 BOX + ROD	
	1 3/4" STYLE 88 ADDRESSER CLAMP				


DATE _____

TOWN OF LEXINGTON — BOARD OF PUBLIC WORKS

WATER DIVISION

W.S. FOR[#] 15-

Sketch of Service Here

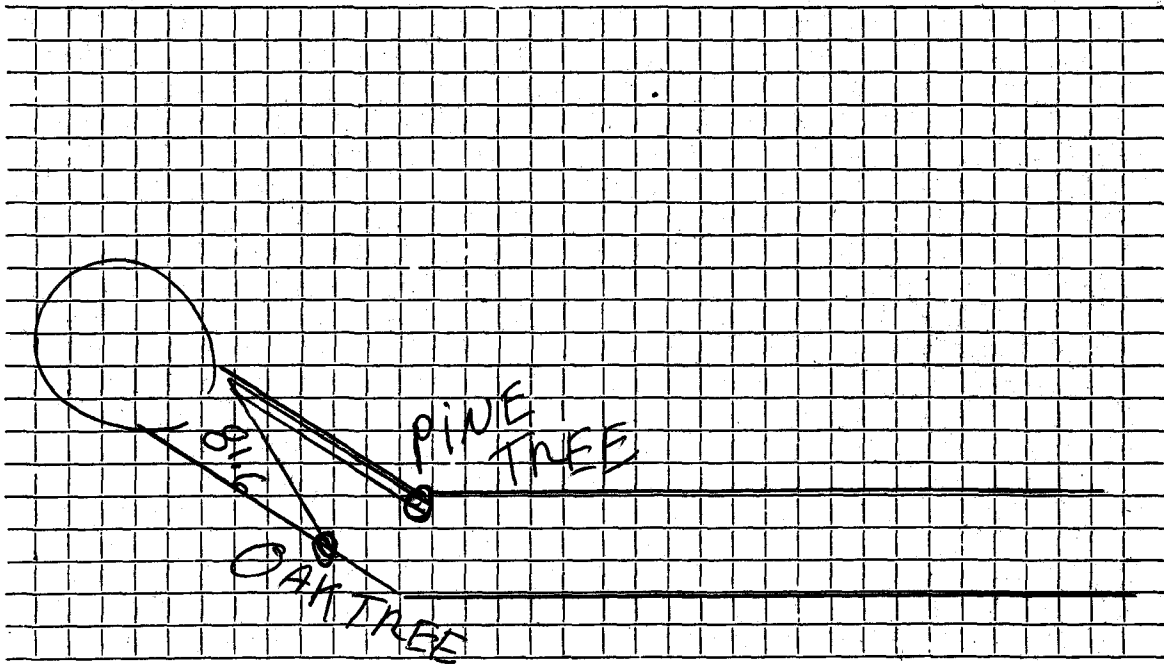

Connection made in Street. Work completed

Remarks:
.....
.....