

WATER SERVICE RECORD

4992

Name

Service No. 233

Address 16 TROTting HORSE DRIVE

LOT 31

Location

Repair—Renewal—New Service

Date	Material	Amount	Total	Date	Amount
10/24/57				10-11-54	
110'	3/4" COPPER TUBING			27'	3/4" COPPER TUBING
1	3/4 C X 1/2 I.W.H. STOP + WASTE			1 -	3/4" C. CORP. COCK
1	3/4 C 3 PART UNION			1	3/4 C CURB - COCK
				1	BOX AND ROD


DATE _____

TOWN OF LEXINGTON — BOARD OF PUBLIC WORKS

WATER DIVISION

W.S. 16

Sketch of Service Here

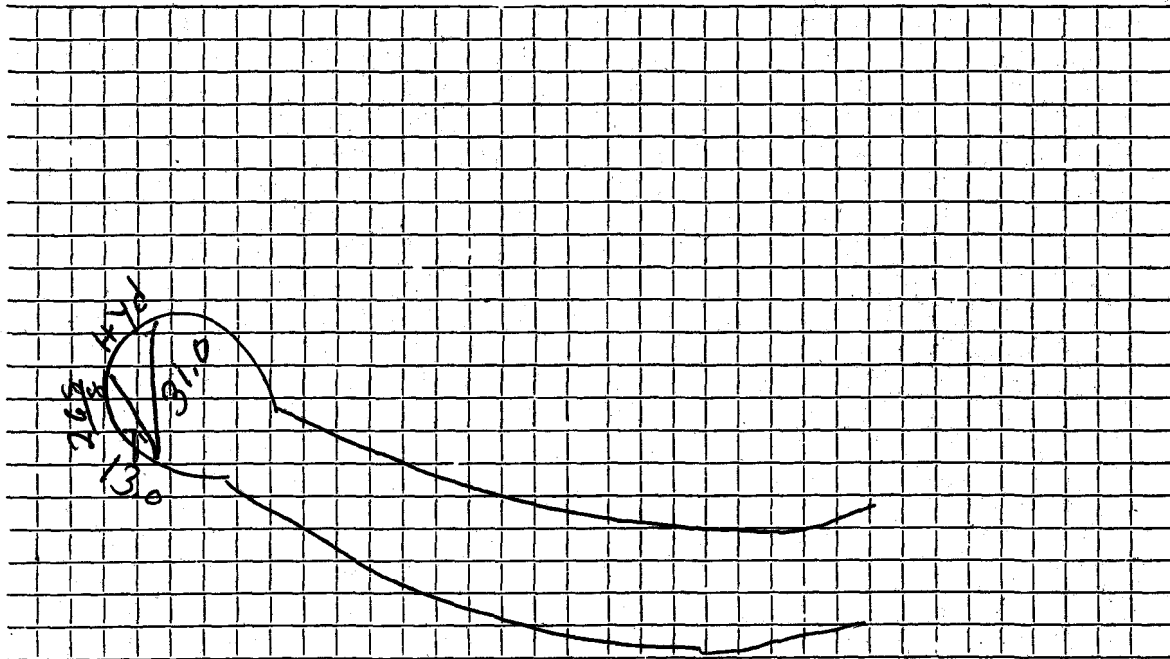

Connection made in Street. Work completed

Remarks:
.....
.....