

WATER SERVICE RECORD

Name

Service No.

Address

17 TROTting HORSE DRIVE

Lot 34

Location

Repair—Renewal—New Service

Date	Material	Amount	Total	Date	Amount
12-20-54				10-11-54	
75'	3/4" COPPER			44'	3/4" COPPER TUBING
1	3/4" C x 1/2" I.W.H STOP + WASTE			1	3/4" C. CORP-COCK
				1	3/4" C. CURB COCK
				1	BOX + ROD


DATE _____

TOWN OF LEXINGTON — BOARD OF PUBLIC WORKS

WATER DIVISION

W.S. 17

Sketch of Service Here

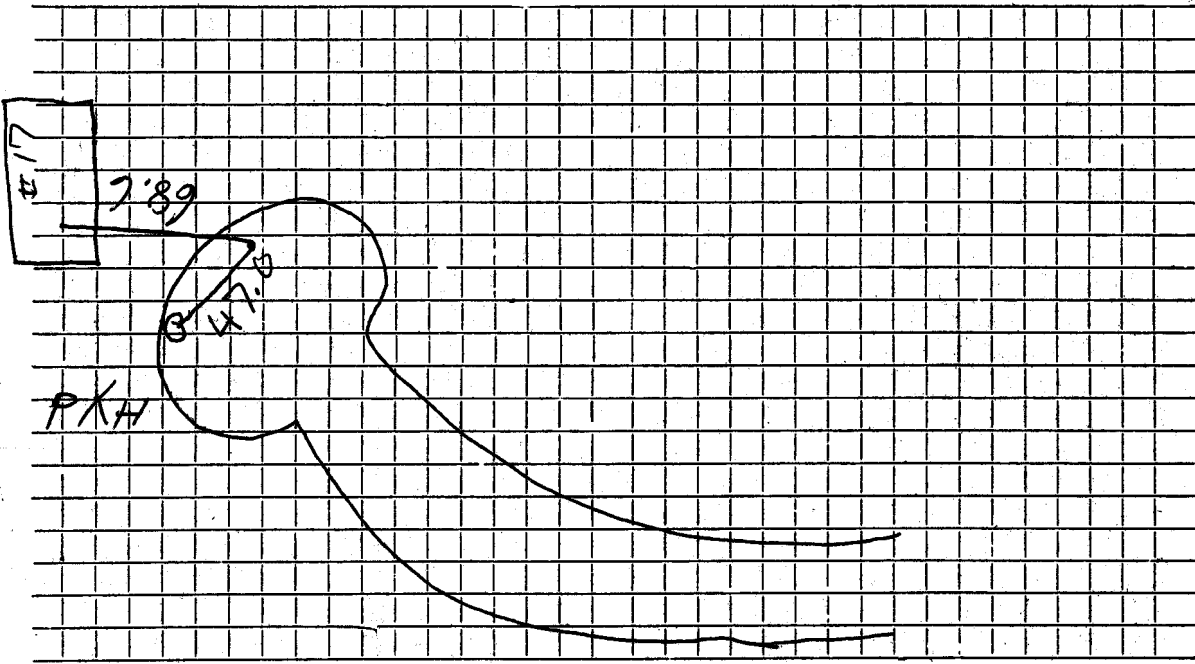

Connection made in Street. Work completed

Remarks:

.....

.....