

WATER SERVICE RECORD

Name

Service No.

Address 6 Trotting Horse Drive (lot 26)

Location

~~REPAIR SERVICE~~ - New Service

SERVICE IN TO CURB:

Date	Material	Amount	Total	Date	Amount
1-7-55					
	102' 3/4" Copper				
	1 3/4" C. X 1/2" I.W.H. Stop + Waste				
	1 3/4" C. Union				
				10/11/54 Labor	3 92
				22' - 3/4" copper tubing @ .35	7 70
				1 - 3/4" C. corp-cock	4 33
				1 - 3/4" C. curb-cock	4 67
				1 box and rod	3 90
				1 hr. trucking	75
					<u>25 27</u>

NON CHARGE


DATE _____

TOWN OF LEXINGTON — BOARD OF PUBLIC WORKS

WATER DIVISION

Sketch of Service Here

W.S. FOR # 6

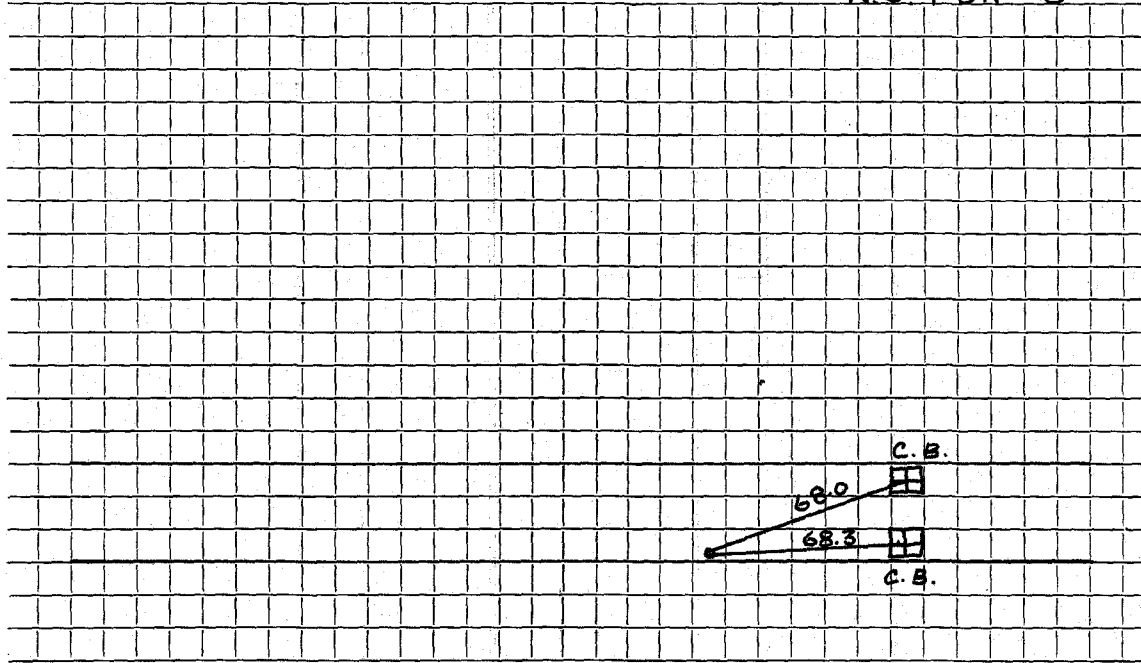

Connection made in Street. Work completed

Remarks:

.....

.....