

WATER SERVICE RECORD

Name

Service No.

Address 7 Trotting Horse Drive (lot 24)

Location

~~REPAIR CHARGE~~ - New Service

SERVICE IN TO CURB:

Date	Material	Amount	Total	Date	Amount
11-2-55	51' 3/4" Copper				
	1 3/4" X 1/2" I.W.H. Stop & Waste				
					<u>NON CHARGE</u>
				10/11/54 Labor	3 93
				10' - 3/4" copper tubing @ .35	3 50
				1 - 3/4" C. corp-cock	4 33
				1 - 3/4" C. curb-cock	4 67
				1 box and rod	3 90
				1 hr. trucking	75
					<u>21 08</u>


DATE _____

TOWN OF LEXINGTON — BOARD OF PUBLIC WORKS

WATER DIVISION

Sketch of Service Here

W.S. FOR # 7

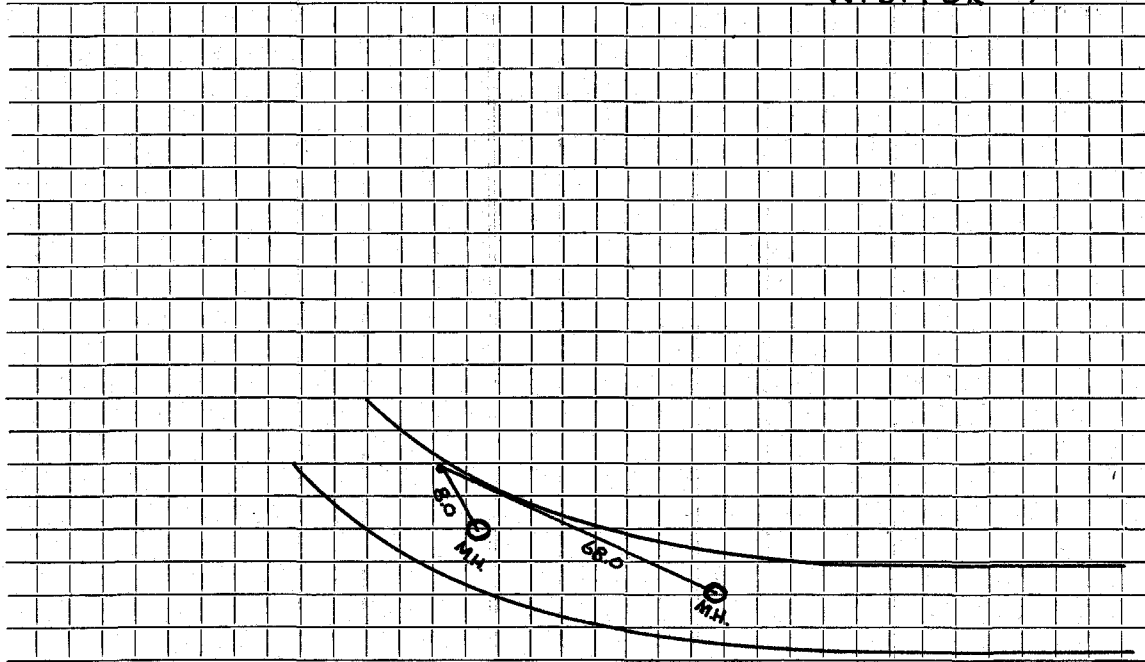

Connection made in Street. Work completed

Remarks:

.....

.....