

Name

Service No. ^{#4350} 2688

Address

Location *16 Tucker Ave.*

Kind of Pipe

Size

Size of Main

Repair—Renewal—New Service

Location

Date

Material

Amount

Total

Date

*Outside:
3/4 Copper*

Amount

6-9-05 CT

Labor

Hadley Press, Inc., Lexington

DATE _____

TOWN OF LEXINGTON—BOARD OF PUBLIC WORKS

WATER DIVISION

The undersigned applies for a supply of water at No. _____ St. and hereby agrees to comply with the rules and regulations as now, or at any future time, established by the Board of Selectmen.

Am't. of Estimate \$ _____


Owner Arthur G. Folger

Am't. Paid \$ _____

Address 16 Tucker Ave

Builder _____

Sketch of Service Here

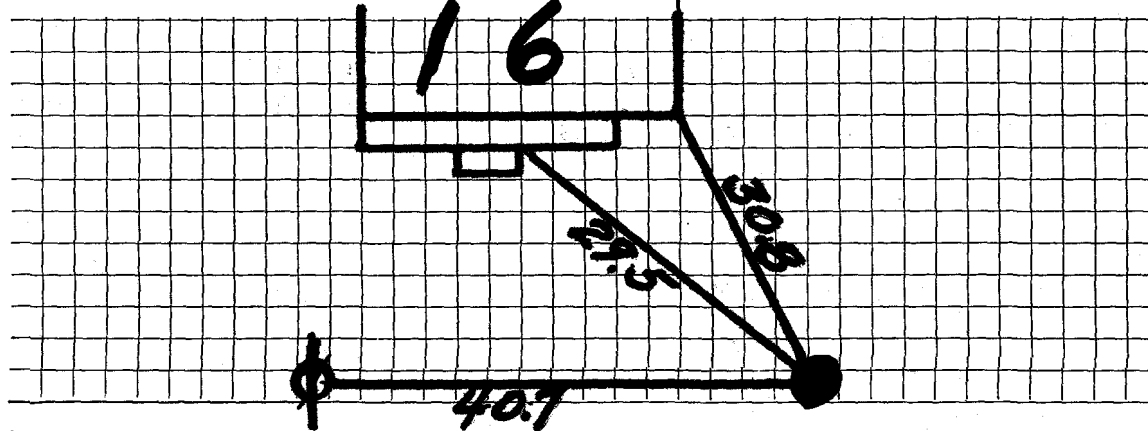

Connection made in _____ Street.

Work completed _____ 19


Remarks:

DATE _____

TOWN OF LEXINGTON — BOARD OF PUBLIC WORKS

WATER DIVISION

Sketch of Service Here

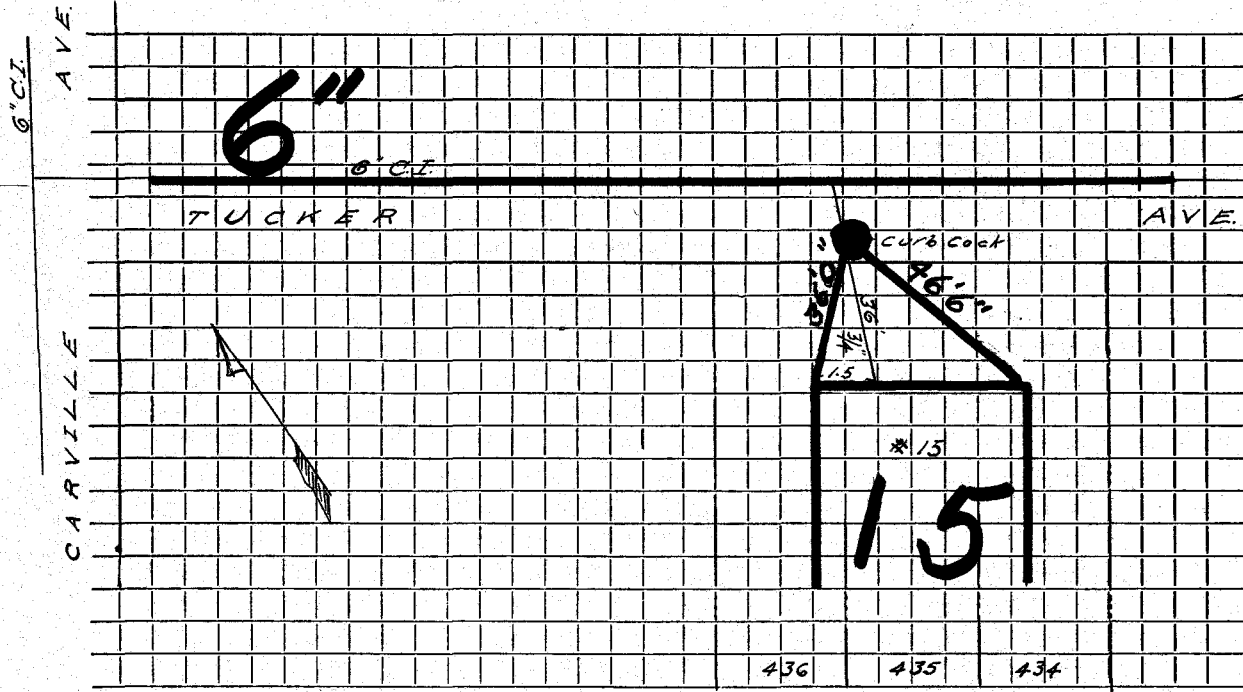

Connection made in Street. Work completed

Remarks:
.....
.....