




DATE \_\_\_\_\_

TOWN OF LEXINGTON — BOARD OF PUBLIC WORKS

WATER DIVISION

Sketch of Service Here

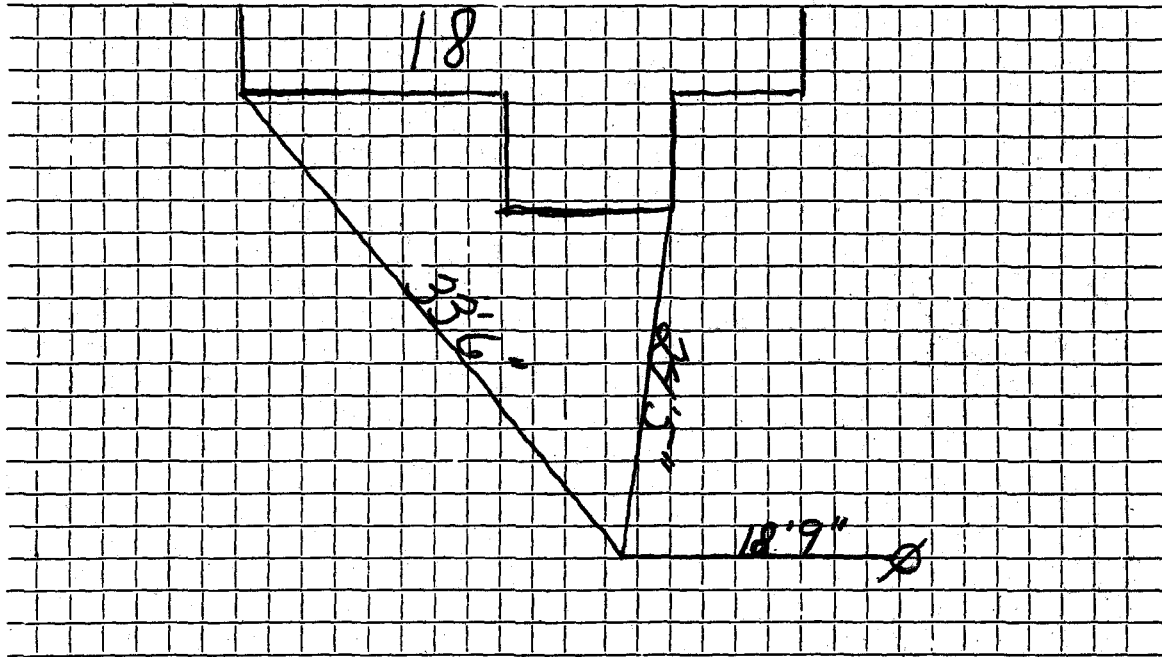

Connection made in ..... Street. Work completed .....

Remarks: .....  
.....  
.....

Name Mr. John Audick

Service No. 32

2689

Address ~~22~~ 34 Tucker Ave.

Location ~~22~~ 34 Tucker Ave.

Kind of Pipe

Size

Size of Main

Repair - Renewal - New Service

Location

Date	Material	Amount	Total	Date	Amount
P. 6-16-31 for 27.00	32 1" C.L. Pipe @ .27	8 64		June 12 1931 - Cash	27
	1 1" L.L. Coup.	30			
	2 1" L.L.E. ls @ .35	70			
	2 1" Br. Sp. Nip. @ .25	50			
	1 S & W	3 00			
	Trucking	75	13 89		
6/18/31	7 Hrs. Labor @ .55	3 85			
	2 " " @ .60	1 20	5 05		
	15% Overhead		76		
<u>COST</u>			19 70		
	<b>Labor</b>				
<u>CHARGE</u>	32 ft. @ .75 per ft.	\$24 00	\$24 00		
8/10	Refused		3 5		
			27		

Hadley Press, Inc., Lexington

*French dug*

DATE June 12, 1931

TOWN OF LEXINGTON—BOARD OF PUBLIC WORKS  
WATER DIVISION

The undersigned applies for a supply of water at No. 31 Tucker Ave St. and hereby agrees to comply with the rules and regulations as now, or at any future time, established by the Board of Selectmen.

Am't. of Estimate \$ 27

Owner John Audick


Am't. Paid \$ 27

Address 34 Tucker Ave.

Builder \_\_\_\_\_

E. Lexington Mass

Sketch of Service Here

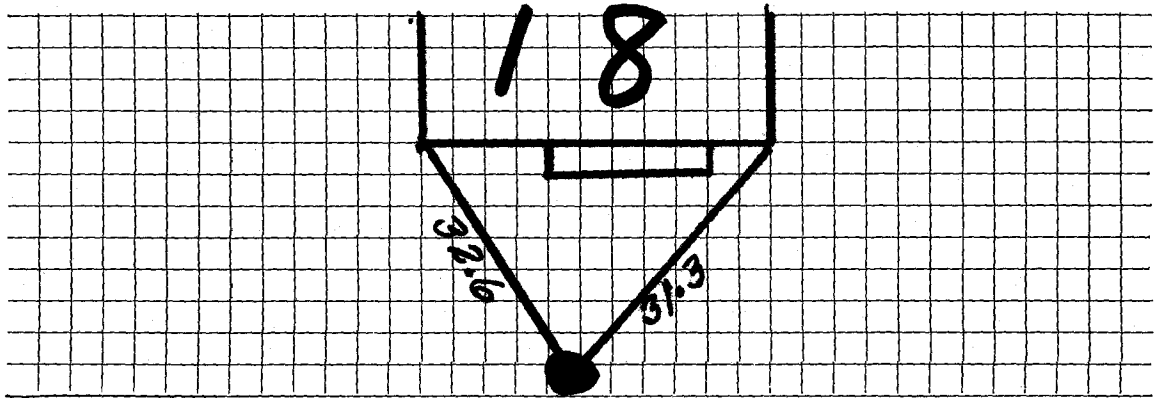

Connection made in \_\_\_\_\_ Street.

Work completed \_\_\_\_\_ 19

Remarks: