

## WATER SERVICE RECORD

Name Ace Construction Trust

Service No. 32

Address 21 Tucker Avenue

Location

~~Repair Record~~ — New Service Valeri Construction Permit #A-323 - W.O. #2447

OCT 3 1966


Date	Material	Amount	Total	Date	Amount
6/15/66	Labor	21 11		6-3-66	50 00
	10% O.H.	2 11	23 22	12-6-66	15 85
	15' 3/4" copper tubing @ .79		11 85		65 85
	1 3/4" Corp. Cock		7 42		
	1 3/4" Curb Cock		8 76		
	1 Box & Rod		5 10		
	1 Hr. Trucking		3 00		
	1 Hr. Shovel		6 50		
			65 85		
6-18-66	41' 3/4" copper tubing				
					Bill sent 15.85

DATE \_\_\_\_\_

TOWN OF LEXINGTON — BOARD OF PUBLIC WORKS

WATER DIVISION

Sketch of Service Here

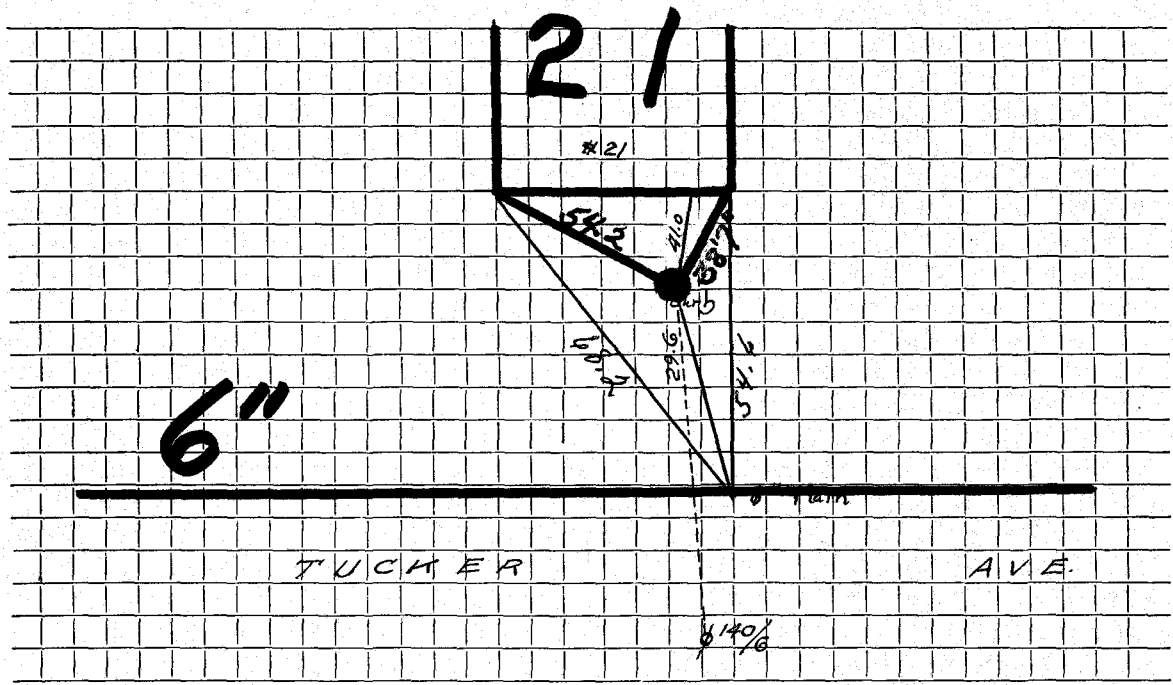

Connection made in ..... Street. Work completed .....

Remarks: .....  
.....  
.....