

Name Louis Vanderwoude

Service No. ~~21~~ 2693

Address 41 Baker Avenue

# 4526

Location

<sup>29</sup>  
~~Corner Baker &~~ Tucker Aves.

Kind of Pipe

Size

Size of Main

~~Repair Renewal~~ New Service

Location

Date  
1937

Material

Amount

Total

Date

Amount

5/27/37

2 hrs. @ 60 ¢

1 20

1 20

May 28 1937

Deposited  
Refund

28 50

31' 3/4" Cop. Tubing @ 25¢

25¢

7 75

300

1 3/4" S. & W.

3 75

50

1 3/4" I. Union

25

2 hrs. trucking @ 75¢

1 50

\$14 65

Say:

31' @ 50¢

15 50

Patching

5 00

\$ 20 50

Labor

27' to curb  
50  
13.50  
12.00  
25.50

DATE May 21, 1939

# TOWN OF LEXINGTON—BOARD OF PUBLIC WORKS

## WATER DIVISION

The undersigned applies for a supply of water at No. Cor. Baker & Tucker Ave. and hereby agrees to comply with the rules and regulations as now, or at any future time, established by the Board of Selectmen.

Am't. of Estimate \$ 23.50

Owner

Louis Vander Woude

Am't. Paid \$ \_\_\_\_\_


Address

41 Baker Ave

Builder \_\_\_\_\_

Lexington

Sketch of Service Here

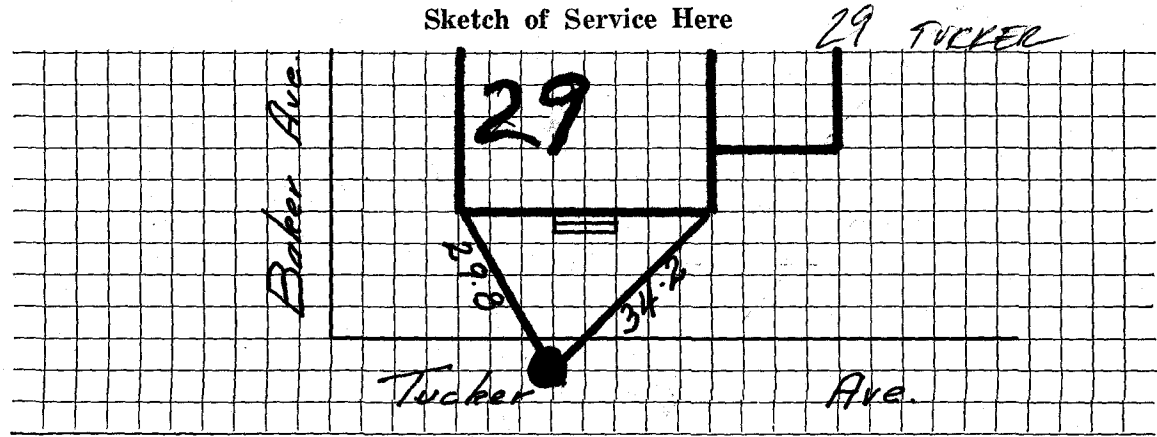

Connection made in 1 Street.

Work completed \_\_\_\_\_ 19

Remarks: