

#6255

WATER SERVICE RECORD

Name R. H. Herson

Service No. 304

Address 5 Tucker Avenue

Location Lexington

~~Repair~~ ~~Renewal~~ New Service COM. 12-8-52

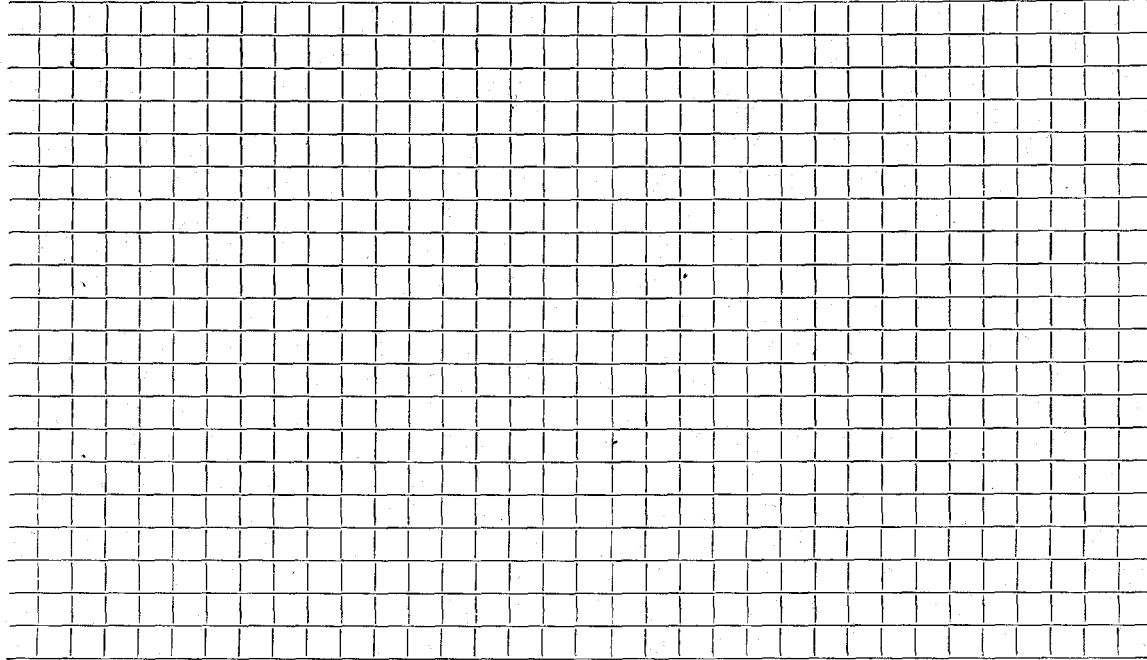
Date	Material	Amount	Total	Date	Amount
11/13/52	Labor	26 76		11-6-52 Deposited	135 00
11/14/52	Labor	20 00		12-8-52 Paid	(11 87
	10% Overhead	4 68	51 44		NON CHARGE
	42' - 3/4" Copper tubing@.34	14 28		11/14/52 Labor	20 14
	105' - 3/4" Coppertubing@.34	35 70		8' - 3/4" Copper tubing@.34	2 72
	1 - 3/4" C x 1/2" D.W.H. stop&waste	4 00		1 - 3/4" C. corp-cock	4 33
	1 - 3/4" C x 3/4" C. curb-cock	4 33		1 - 3/4" C. curb-cock	4 67
	1 - 3/4" C x 3/4" C. U nion	3pts. 1 72		1 box and rod	3 90
	1 box and rod		3 90	1 - 1/2" straight tail piece	50
	4 hrs. town shovel @5.00		20 00	1 - 1/2" offset tail piece	50
	2 hrs. trucking @.75		1 50	1 hr. trucking	75
			136 87	1 hr. Town shovel @5.00	5 00
					42 51

DATE _____

TOWN OF LEXINGTON — BOARD OF PUBLIC WORKS

WATER DIVISION

Sketch of Service Here

A large grid of graph paper, consisting of 20 columns and 20 rows of small squares, intended for sketching service details.

Connection made in Street. Work completed

Remarks:
.....
.....