

WATER SERVICE RECORD

Name Lloyd C. Harding

Service No. 96

Address 50 Tucker Avenue

Location

~~Repair~~ ~~Renewal~~ ~~New Service~~ Renewal

Comm 7-5-60


Date	Material	Amount	Total	Date	Amount
5-27-60	Labor	27.45		6-7-60	50.00
	10% O.H.	2.75	30.20	7-28-60	7.61
	22' 3/4" Copper tubing @.42		9.24		57.61
	1 3/4" x 1/2 I.W.H. Stop & Waste		6.17		NON CHARGE
	1 hr. Trucking @.75	3.00	3.00	5-27-60	Labor
	2 hrs. Pippin Shovel @4.50		9.00		55.25
			57.61		23' 3/4" Copper tubing @.42
					1 3/4" C Adapter
					1 3/4" C Curb Cock
					1 3/4" C 3 part union
					2 hrs. Pippin @4.50
					1 hr. Trucking @.75
					85.25
					Bill sent 7-5-60
					7.61

DATE _____

TOWN OF LEXINGTON — BOARD OF PUBLIC WORKS

WATER DIVISION

Sketch of Service Here

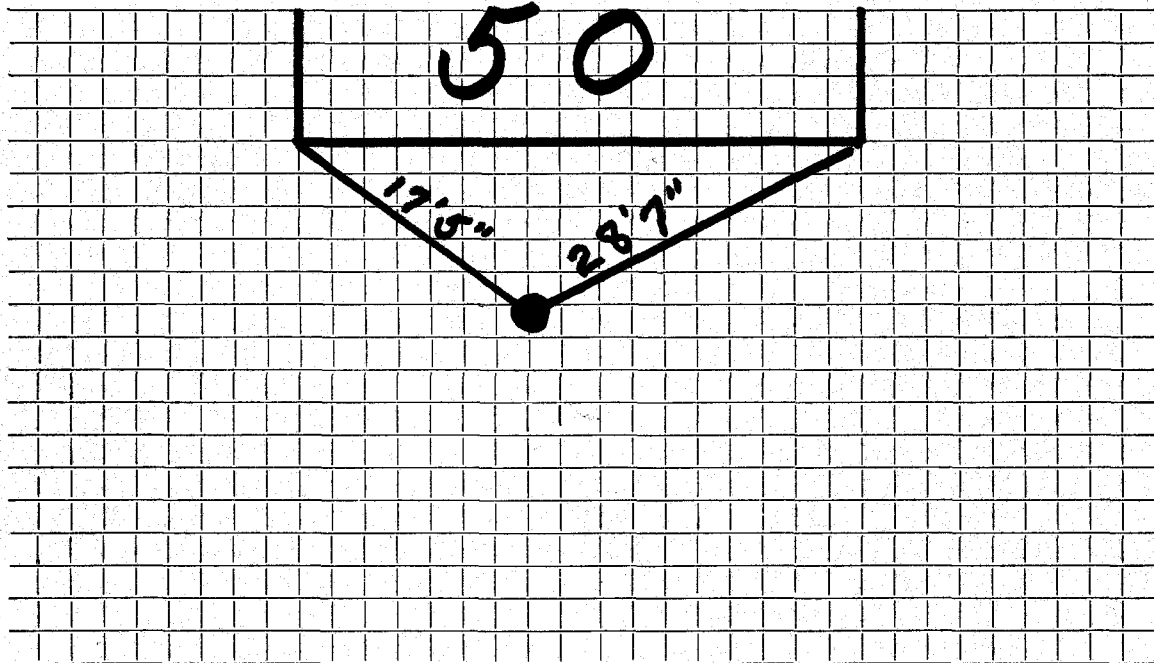

Connection made in Street. Work completed

Remarks:

.....
.....