

WATER SERVICE RECORD

Name Barry Couette

Service No.

Address 8 Tucker Avenue

Location

~~Repair~~ ~~Renewal~~ New Service Redmond 4791


Date	Material	Amount	Total	Date	Amount
7/28/89	<del>69'</del> <del>1" Copper</del>				
	63' 1" Copper				
	1 1" Union			7-28-'89'	
				16' 1" Copper	
				1 1" C. Corp Cock	
				<del>1 1" C. Union</del>	

DATE 9-13-90

TOWN OF LEXINGTON — BOARD OF PUBLIC WORKS

WATER DIVISION

Sketch of Service Here

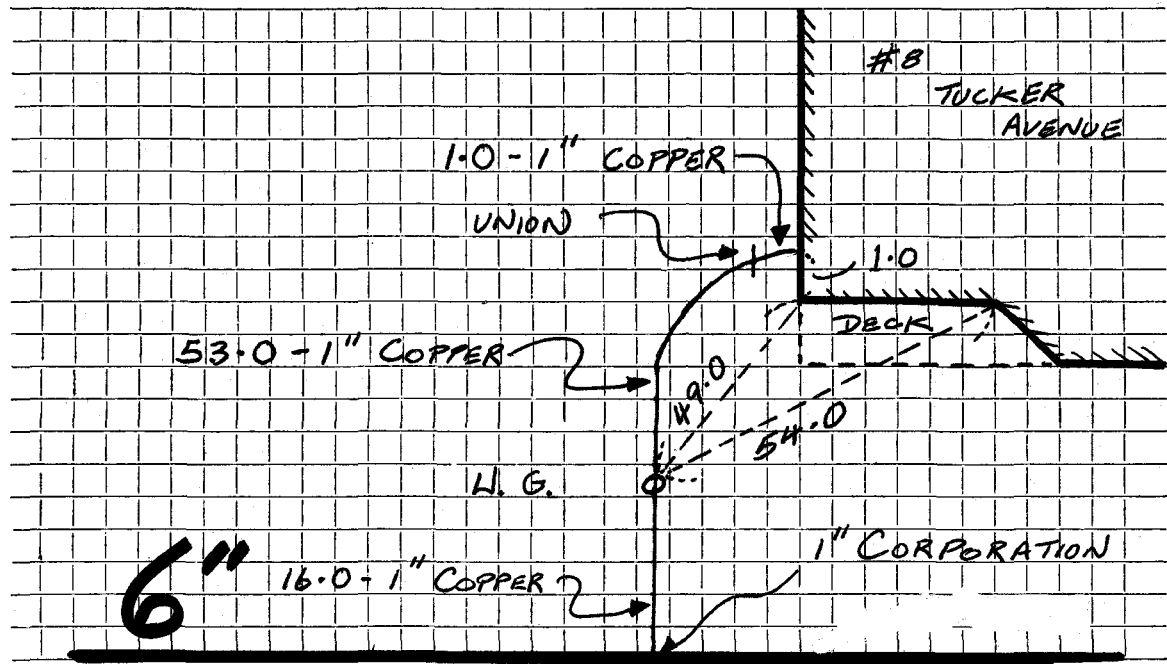

Connection made in TUCKER AVENUE Street. Work completed 6' DEEP

Remarks: .....

.....

.....