

Name Ancil Highton

Service No. 148

Address 9 Tucker Avenue

Lexington, Mass.

Location 9 Tucker Avenue

Kind of Pipe

Size

Size of Main

~~Repair~~ - Renewal - ~~New Service~~

Com. 9-26-49

Location

Date	Material	Amount	Total	Date	Amount
Jul. 26, '49	Labor	9 40	9 40	July 25 '49	6 00
	10% Overhead		94	July 26 '49	15 11
	63' - 3/4" Copper Tubing @.24		15 12		44 89
	1 - 3/4" C x 1/2" I.W.H. S&W		3 29	Jul. 27, '49	10 70
	1 - 3/4" C x 3/4" C Union (3pts)		1 39		1 20
	Shovel 2 hrs. @ 7.00		14 00		3 85
	Trucking 1 hr. @.75		75		1 05
			44 89		2 68
					1 22
					88
					46
					35 00
	Labor				75
					57 79

Deposited
Refunded
No Charge

DATE _____

TOWN OF LEXINGTON - BOARD OF PUBLIC WORKS

WATER DIVISION

The undersigned applies for a supply of water at No..... St. and hereby agrees to comply with the rules and regulations as now, or at any future time, established by the Board of Selectmen.

Am't of Estimate \$.....


Owner

Am't Paid \$.....

Address

Builder

Sketch of Service Here

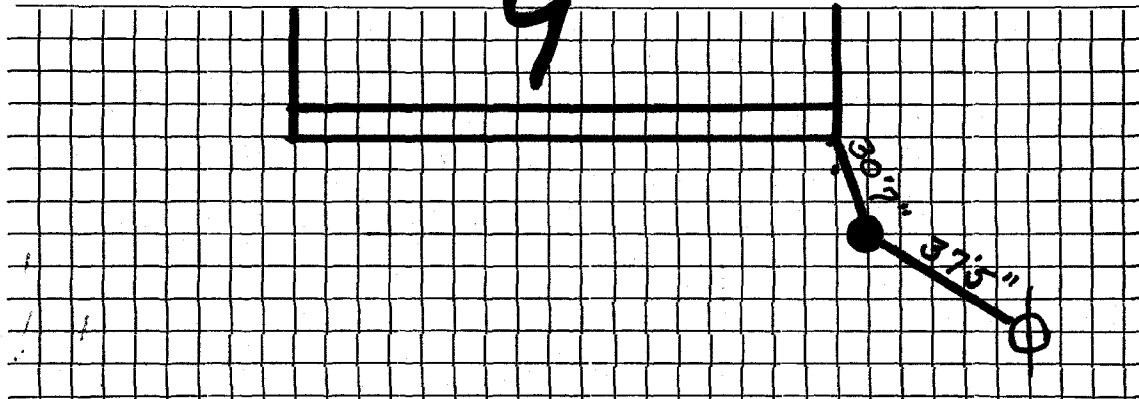

Connection made in Street.

Work completed19

Remarks: