

WATER SERVICE RECORD

Name Cary Realty

Service No. 175

Address #11 Tufts RD.

Location Lot # 349

~~RENEWED~~ New Service

Comm 11-9-59

Date	Material	Amount	Total	Date	Amount
8-12-59	Labor	3.16		8-7-59	Deposit 35.00
	10% O.H.	.31	3.37	11-1-59	Paid 5.96
70'	3/4" Copper tubing @.41		28.70		40.96
1	3/4" C x 1/2 I.W.H. Stop & Waste	5.84			NON CHARGE
1	3/4" C 3 part union	2.30		1	1/2 Straight tailpiece .50
1	hr. Trucking @.75	.75		1	1/2 Offset tailpiece .50
			40.96		1.00

Bill sent 11-9-59


5.96

DATE _____

TOWN OF LEXINGTON — BOARD OF PUBLIC WORKS

WATER DIVISION

Sketch of Service Here

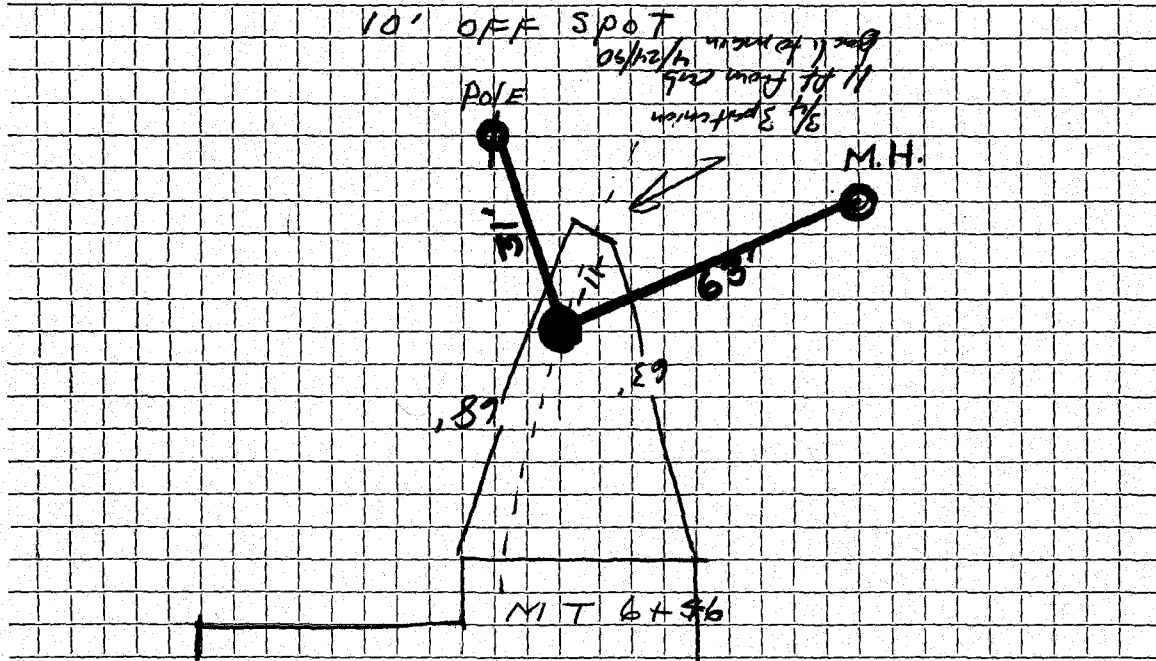

Connection made in Street. Work completed

Remarks:
.....
.....