

WATER SERVICE RECORD

Name George Krikorian

Service No. 232

Address # 12 TUETS RD.

6903

Location LOT # 323

~~Repair—Renewal—New Service~~

Comm. 2/16/59


Date	Material	Amount	Total	Date	Amount
11/18/58	Labor	3 75		10/29/58	Deposit # 25 00
	10% overhead	38	4 13	2/16/59	Pl. by refund on
	44' - 3/4" Copper tubing @ .37		16 28		S. N. C. # 186
	1 - 3/4" Cx $\frac{1}{2}$ I.W.H. Stop & Waste		5 84		NON CHARGE # 27 00
	1 hr. Trucking		75	1 - $\frac{1}{2}$	Straight tailpiece 50
			27 00	1 - $\frac{1}{2}$	Offset tailpiece 50
					1 00

DATE _____

TOWN OF LEXINGTON — BOARD OF PUBLIC WORKS

WATER DIVISION

Sketch of Service Here

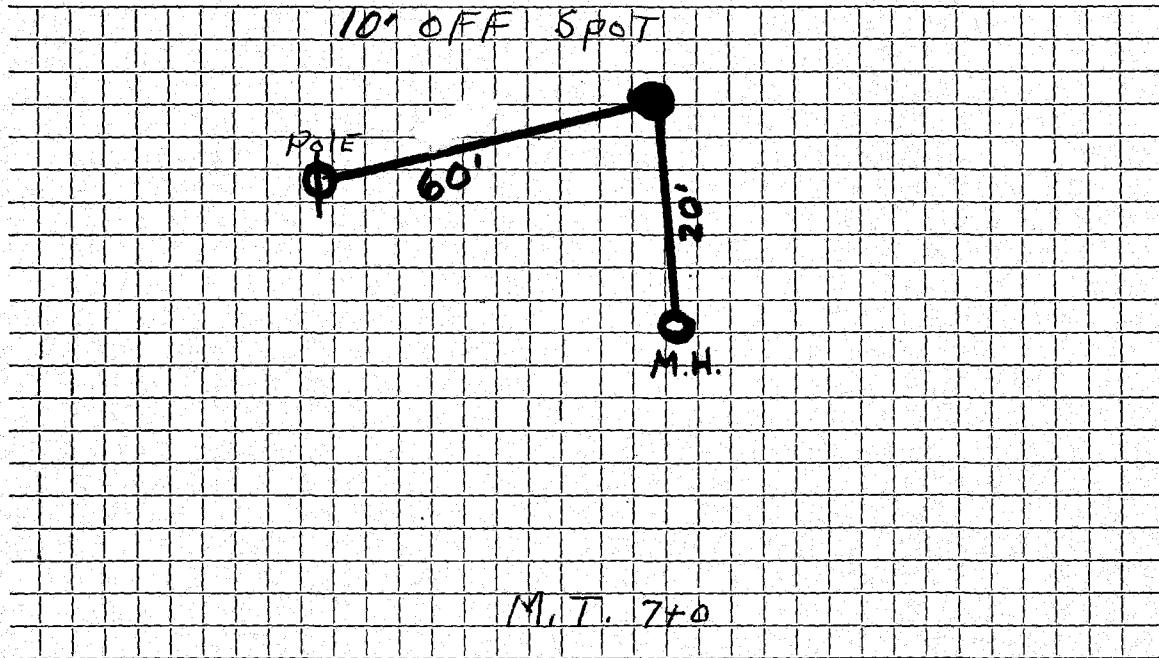

Connection made in Street. Work completed

Remarks:
.....
.....