

WATER SERVICE RECORD

499

Name Leonard Colwell

Service No. 85

Address #15 TUFTS RD.

Location LOT # 350

~~RECHECKED~~ New Service

Comm 7-17-61


Date	Material	Amount	Total	Date	Amount	
6-27-61	Labor	2.04		6-27-61	Deposit	50.00
	10% O.H.	.20	2.24	7-17-61	Refund	11.88
	65' 3/4" Copper Tubing @.42		27.30			38.12
	3 3/4" C X 1/2 I.W.H. Stop & Waste		6.17			
	1 3/4" C 3 part union		2.41		NON CHARGE	
			38.12	6-27-61	1/2 Straight tailpiece	.50
					1/2 Offset tailpiece	.50
						1.00

DATE _____

TOWN OF LEXINGTON — BOARD OF PUBLIC WORKS

WATER DIVISION

Sketch of Service Here

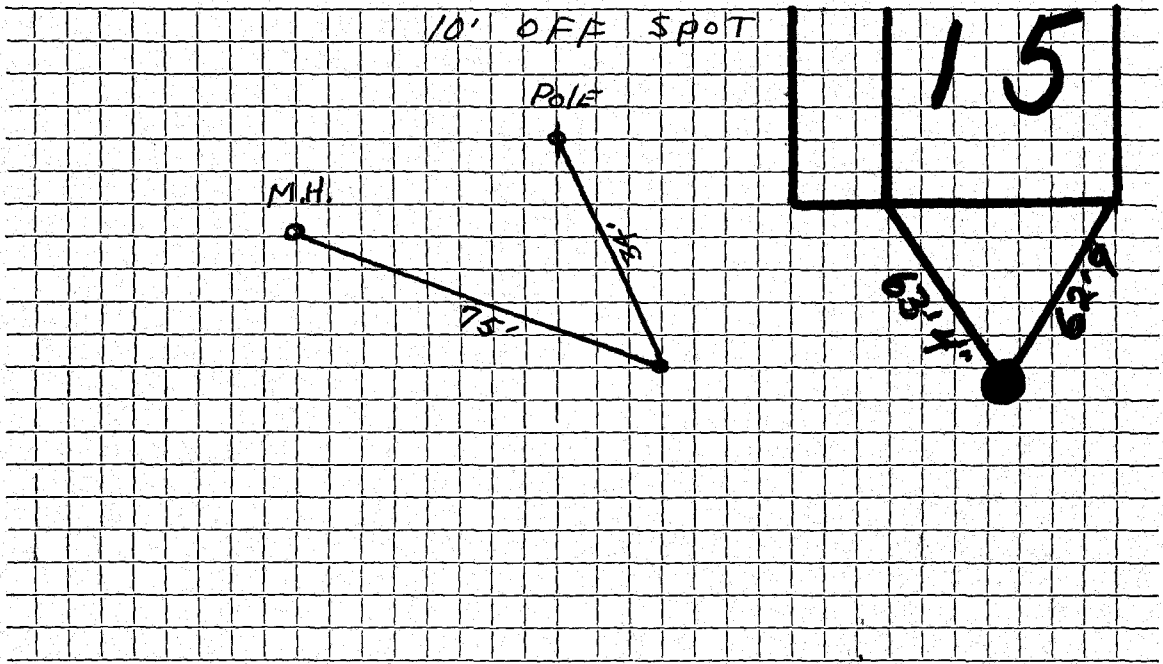

Connection made in Street. Work completed

Remarks:
.....
.....