

## WATER SERVICE RECORD

1100

Service No. 82

Name Ralph Mondano

Address # 18 Tufts Rd.

Location Lot # 325

~~Renewal~~ New Service

Comm 8-1-60


Date	Material	Amount	Total	Date	Amount
6-6-60	Labor	1 94		5-31-60	50 00
	10% O.H.	19	2 13	8-1-60	16 50
60'	3/4" Copper tubing @42		25 20		33 50
1	3/4" Cx $\frac{1}{2}$ I.W.H. Stop&Waste		6 17		
			33 50		
					NON CHARGE
				1 $\frac{1}{2}$ "	Straight tailpiece 50
				1 $\frac{1}{2}$ "	Offset tailpiece 50
					1 00

DATE \_\_\_\_\_

TOWN OF LEXINGTON — BOARD OF PUBLIC WORKS

WATER DIVISION

Sketch of Service Here

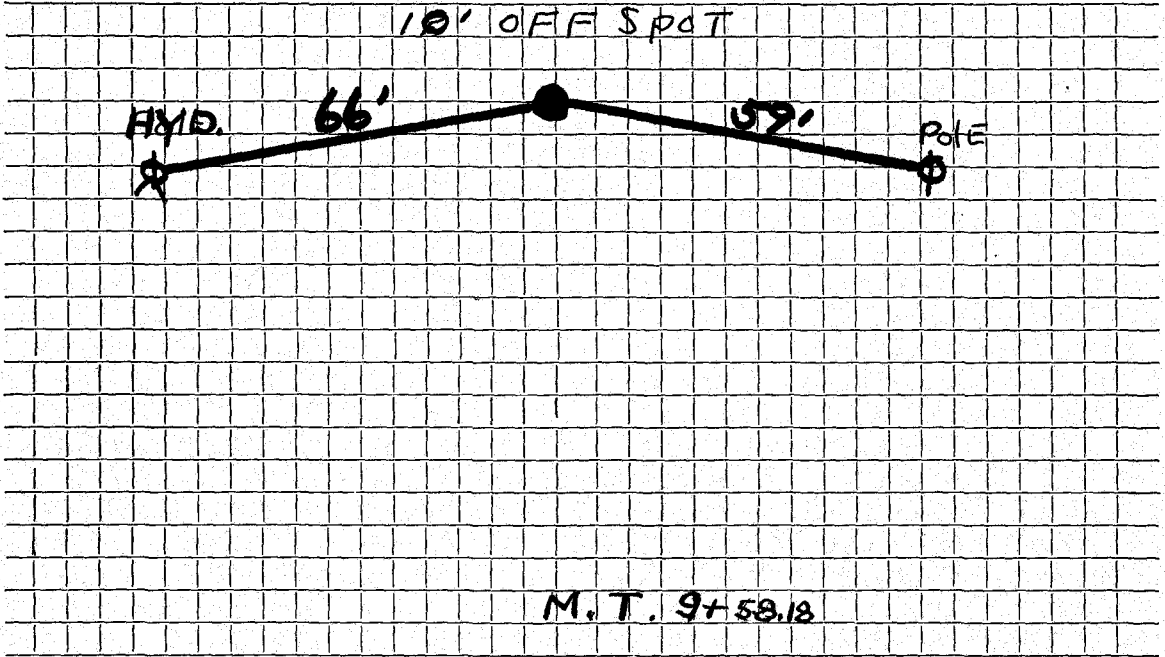

Connection made in ..... Street. Work completed .....

Remarks: .....  
.....  
.....