

WATER SERVICE RECORD

5188

Name Joseph Spinelli

Service No. 86

Address # 21 Tufts RD.

Location Lot # 331

~~Residence~~ New Service


Comm 8-1-60

Date	Material	Amount	Total	Date	Amount	
6-13-60	Labor	1 77		6-8-60	Deposit	50 00
	10% O.H.	18	1 95	8-1-60	Returned	14 24
	42' 3/4" Copper tubing @42		17 64			30 76
	1 3/4" Cx 1/2 I.W.H. Stop&Waste		6 17			
	1 Curb Box&Rod		5 00		NON CHARGE	
			30 76		1 1/2 Straight tailpiece	50
					1 1/2 Offset tailpiece	50
						1 00

TOWN OF LEXINGTON — BOARD OF PUBLIC WORKS

WATER DIVISION

Sketch of Service Here

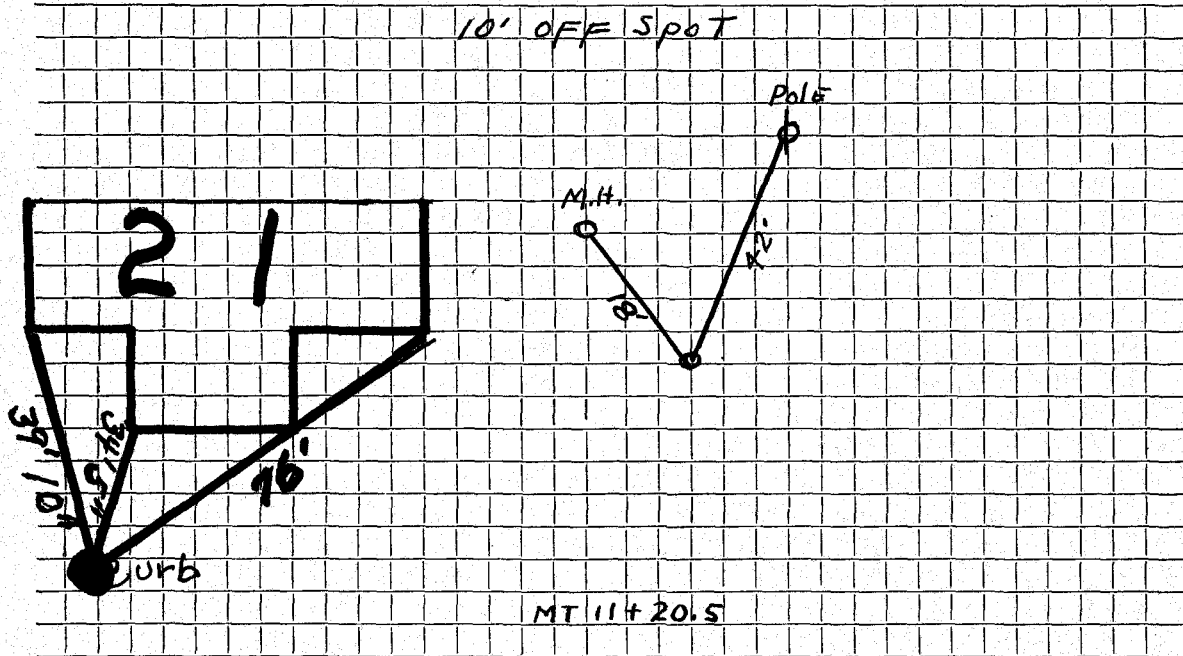

Connection made in Street. Work completed

Remarks:
.....
.....