

WATER SERVICE RECORD

Name Oman-McCormick Const. Co.

Service No. 7

Address # 22 TUFTS RD.

Location LOT # 327

~~NEW SERVICE~~ - New Service


Comm. 4/29/57

Date	Material	Amount	Total	Date	Amount
3-7-57	Labor	1.55		3-4-57	Deposit \$50 00
	10% C.H.	.16	1.71	4-29-57	Refund 17 21
60'	3/4" Copper tubing @ .4228 waste		25.37		\$ 32 79
1	3/4" C x 1/2 I.W.H. Stop & Waste		4.96		NON CHARGE
1	1/4" Trucking @ .75		.75	1 1/2	Straight tail piece .50
			32.79	1 1/2	Offset tail piece .50
					1.00

DATE _____

TOWN OF LEXINGTON — BOARD OF PUBLIC WORKS
WATER DIVISION

Sketch of Service Here

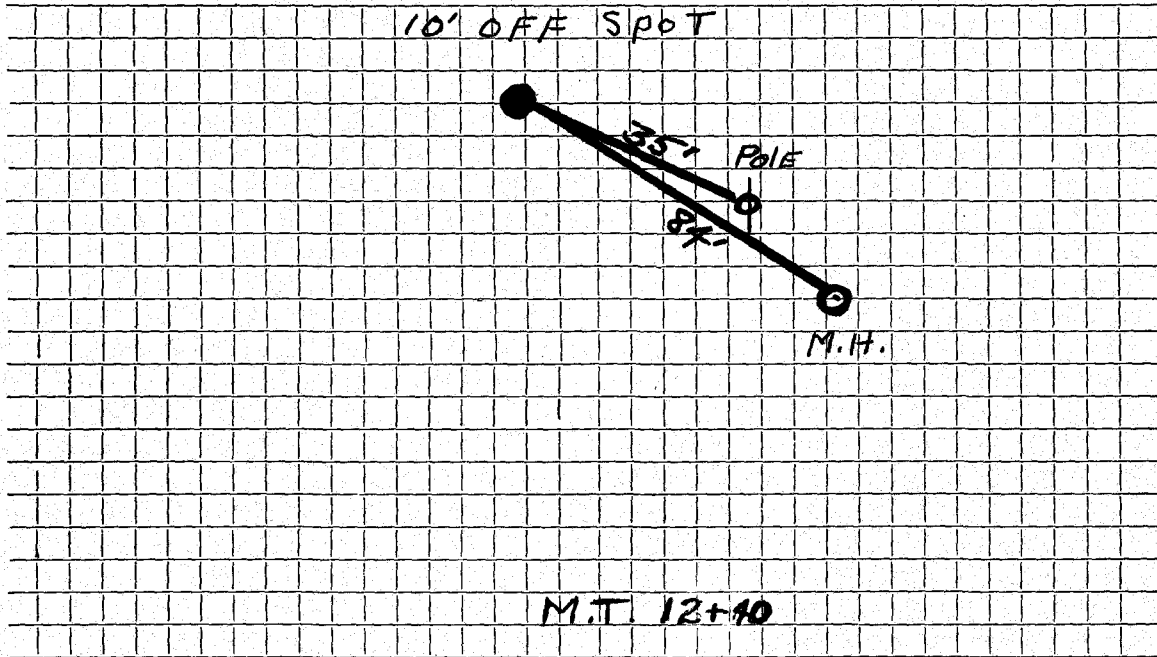

Connection made in Street. Work completed

Remarks:
.....
.....