

WATER SERVICE RECORD

1340 + 1341

Name Joseph P. Spinelli

Service No. 87

Address # 23 Tufts RD.

3172

Location Lot # 330

~~XXXXXXXXXX~~ - New Service

Comm 8-1-60


Date	Material	Amount	Total	Date	Amount	
6-13-60	Labor	1 77		6-8-60	Deposit	50 00
	10% O.H.	18	1 95	8-1-60	Retained	7 17
65'	3/4" Copper tubing @42		27 30			42 83
1	3/4" Cx 1/2 I.W.H. Stop&Waste		6 17			
1	3/4" C3 part Union		2 41		NON CHARGE	
1	Curb Box&Rod		5 00	1	1/2 Straight tailpiece	50
			42 83	1	1/2 Offset tailpiece	50
						1 00

DATE _____

TOWN OF LEXINGTON — BOARD OF PUBLIC WORKS

WATER DIVISION

Sketch of Service Here

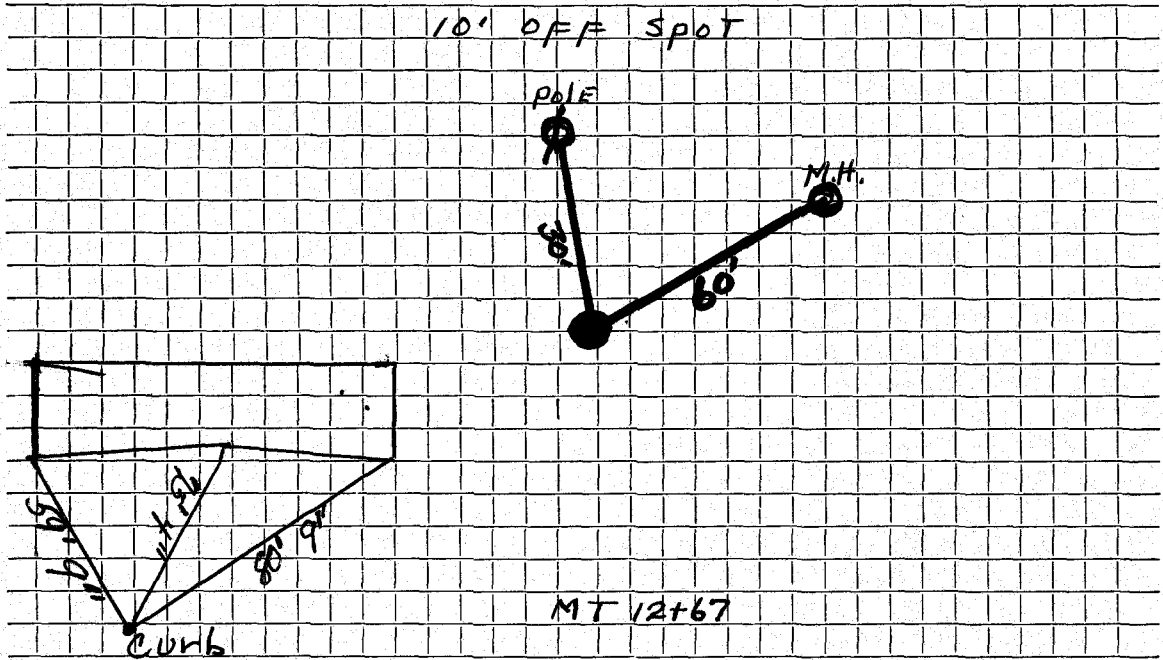

Connection made in Street. Work completed

Remarks:
.....
.....