


DATE _____

TOWN OF LEXINGTON — BOARD OF PUBLIC WORKS

WATER DIVISION

Sketch of Service Here

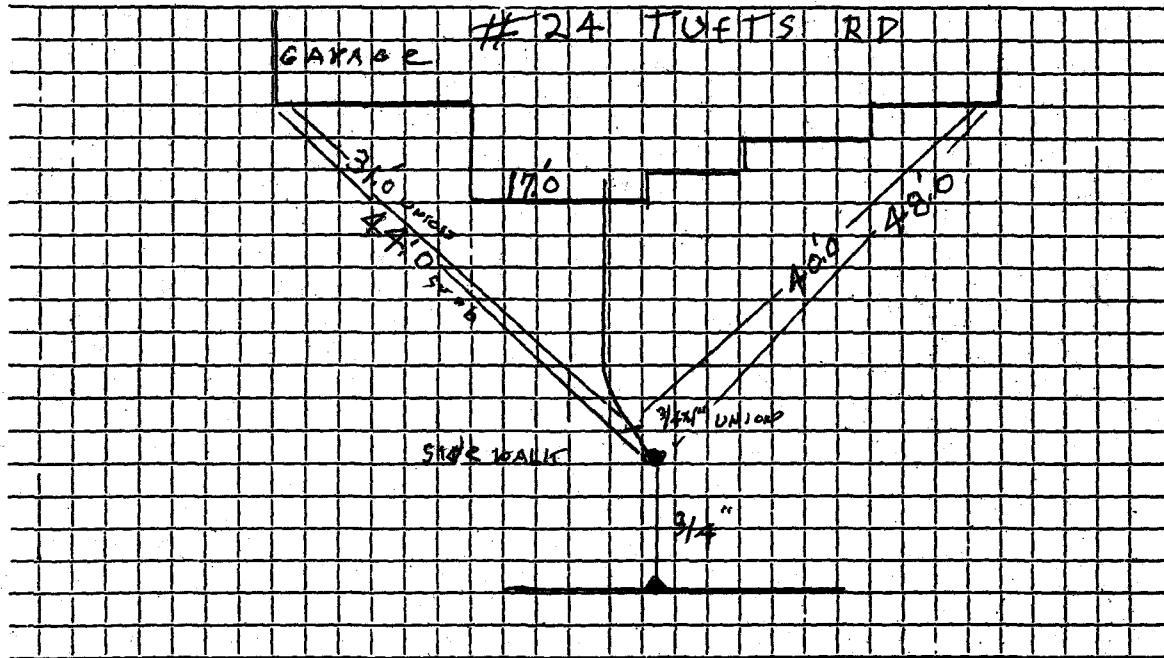

Connection made in Street.

Work completed 10/24/07 J. M. C. I.

Remarks: SERVICE WAS INTO GARAGE NO INFO