

WATER SERVICE RECORD

Name Joseph Spinelli

Service No. 88

Address # 25 Tufts Rd.

Location Lot # 329

~~Repair/Extension~~ New Service


Comm 8-1-60

Date	Material	Amount	Total	Date	Amount
7-6-60	Labor	3 71		6-8-60	Deposit 50 00
	10% O.H.	37	4 08	8-1-60	Paid by 51124984114 5 92
103'	3/4" Copper tubing @42		43 26		55 92
1	3/4" Cx 1/2 I.W.H. Stop&Waste		6 17		
1	3/4" C3 part Union		2 41		NON CHARGE
			55 92	1 1/2	Straight tailpiece 50
				1 1/2	Offset tailpiece 50
					1 00

TOWN OF LEXINGTON — BOARD OF PUBLIC WORKS

WATER DIVISION

Sketch of Service Here

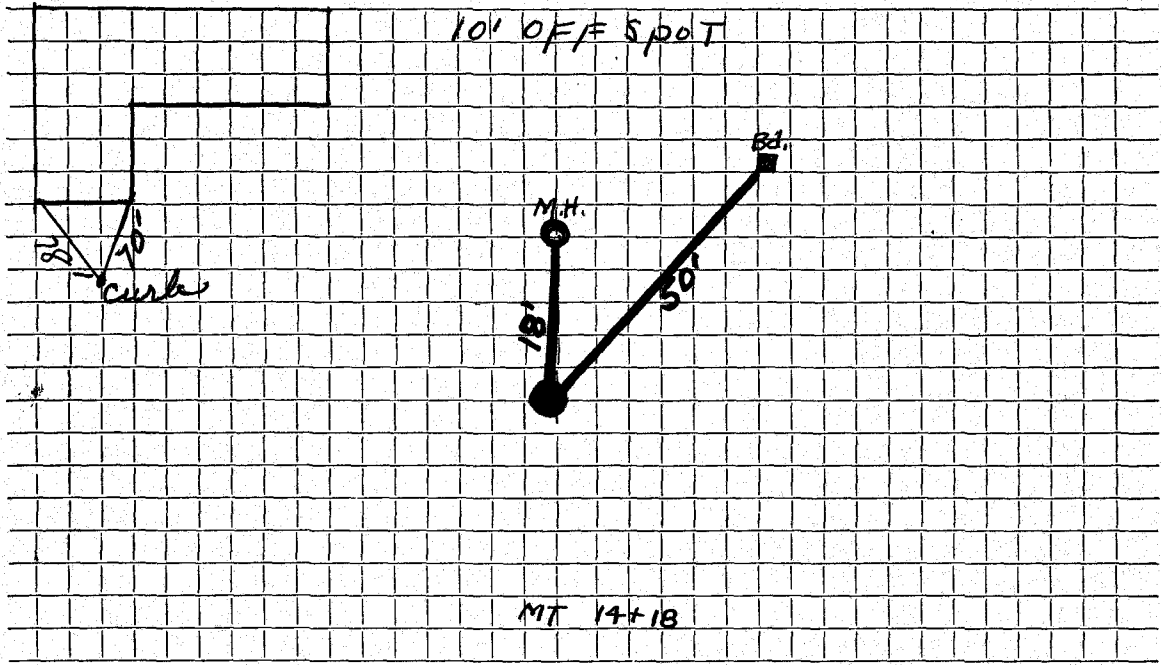

Connection made in Street. Work completed

Remarks:
.....
.....