

WATER SERVICE RECORD

Name Leonard Caldwell

Service No. 125

Address # 4 TUFTS RD.

Location LOT # 319

~~WATER SERVICE~~ - New Service

W.O. # 1603


Comm 10-31-62

Date	Material	Amount	Total	Date		Amount
9-22-62	Labor	4.02		9-17-62	Deposit	50.00
	10% O.H.	.40	4.42	10-27-62	ReFund	16.31
55'	3/4" Copper tubing @.42		23.10			33.69
1	3/4" C x 1/2 I.W.H. Stop & Waste		6.17		NON CHARGE	
			33.69	1	1/2 Straight tailpiece	.50
				1	1/2 Offset tailpiece	.50
						1.00

TOWN OF LEXINGTON — BOARD OF PUBLIC WORKS

WATER DIVISION

Sketch of Service Here

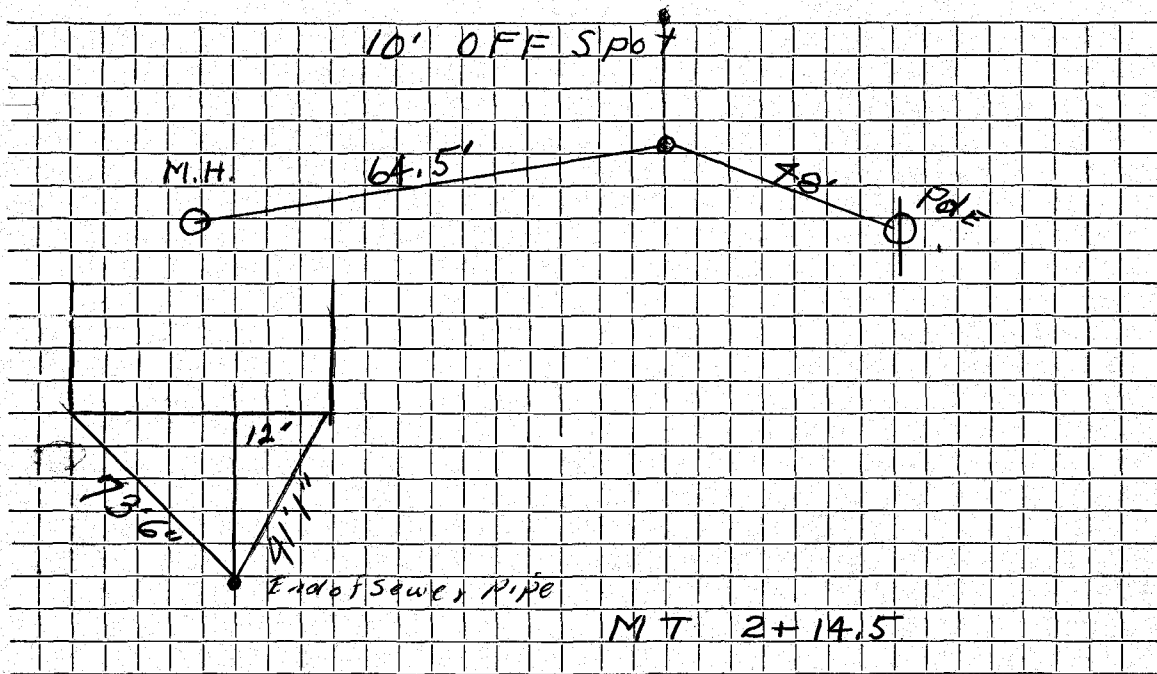

Connection made in Street. Work completed

Remarks:

.....

.....