

WATER SERVICE RECORD

Name Advance Builders Realty Trust

Service No. 208

Address # 6 Tufts Rd.

7470

Location Lot # 320


~~Water Extension~~ - New Service

Comm 11-21-60

Date	Material	Amount	Total	Date	Amount	
10-4-60	Labor	1 94		9-27-60	Deposit	50 00
	10% O.H.	19	2. 13	11-21-60	Retained	23 53
	38' 3/4" Copper tubing @42		15 96			26 67
	1 3/4" Cx 1/2 I.W.H. Stop&Waste		6 17			
	1 3/4" C3 part union		2 41		NON CHARGE	
			26 67			
				1	1/2 Straight tailpiece	50
				1	1/2 Offset tailpiece	50
						1 00

TOWN OF LEXINGTON — BOARD OF PUBLIC WORKS
WATER DIVISION

Sketch of Service Here

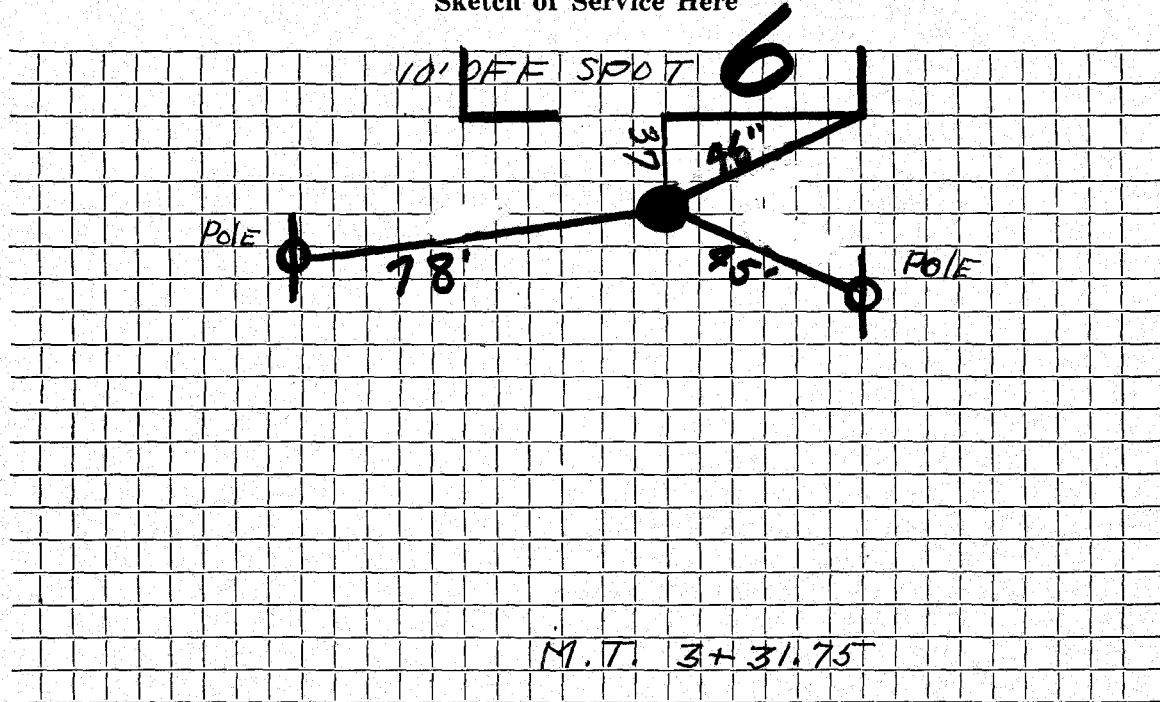

Connection made in Street. Work completed

Remarks:

.....
.....